




*Hedgwick*

Map No. **KANSAS** Sec. *18* Twp. *26* R. *1<sup>E</sup>*

Well No. *1- Lot 80 83* Farm

*J. W. Flake et al* Company

..... Ft. from N. Line  
*330*  
~~*990*~~ Ft. from S. Line  
*200*  
~~*330*~~ Ft. from E. Line  
 ..... Ft. from W. Line

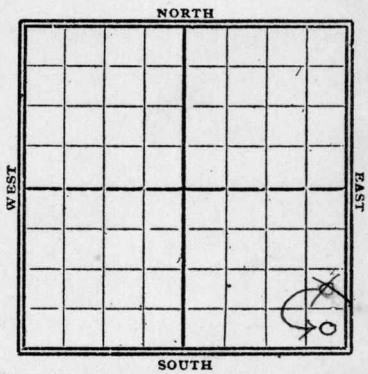

*1928*

Date	REPORT
<i>11/21</i>	<i>Rigs</i>
	<i>(105 A tract Var View Add)</i>
<i>11/28</i>	<i>Rig</i>
<i>12/5</i>	—
<i>12/12</i>	—
<i>12/19</i>	—
<i>12/26</i>	<i>Rign up</i>
<i>1929</i>	<i>Spud</i>
<i>1/2</i>	<i>Spud</i>
<i>1/9</i>	<i>log pipe 520'-T.D.</i>
<i>1/16</i>	<i>Spudding rig south</i>
<i>1/23</i>	<i>Spud</i>
<i>1/30</i>	<i>Drly 795'</i>
<i>2/6</i>	<i>SD. 795'</i>
<i>2/13</i>	<i>drly 1450'</i>
<i>2/20</i>	<i>" 1735'</i>
<i>2/27</i>	<i>SD. 1850'-T.D.</i>
<i>3/6</i>	—
<i>3/13</i>	—
<i>3/20</i>	—
<i>3/27</i>	—
<i>4/3</i>	—

4/10 - Nrlg 1900'

4/17 - S.D. 1900'

4/24 —

5/1 —

5/8 —

5/15 —

5/22 —

5/29 - T.D. 1965'

Dry & Abandoned

*Seelyworth*  
K13 **KANSAS**

MAP NO. KANSAS SEC. 18 TWP. 26 R. 1E

WELL NO. 1 Lot 80

T. W. Flake & Dal COMPANY

CONTRACTOR

**SECTION PLAT**

			0

\_\_\_\_\_ FT. FROM N. LINE

990 FT. FROM S. LINE

330 FT. FROM E. LINE

\_\_\_\_\_ FT. FROM W. LINE

**FIRST REPORTS**

LOCATION \_\_\_\_\_

RIG UP \_\_\_\_\_

DRILLING AND REMARKS:

*RO G.*  
*105 acre Tract.*  
*Van Buren addition*

**RECORD**

CASED \_\_\_\_\_ IN., \_\_\_\_\_ FT.

SAND \_\_\_\_\_

GAS \_\_\_\_\_

OIL \_\_\_\_\_

TOTAL DEPTH \_\_\_\_\_

**PRODUCTION**

1ST 24 HRS. NAT. \_\_\_\_\_

1ST 24 HRS. AFTER SHOT \_\_\_\_\_

GAS \_\_\_\_\_ CU. FT.

DRY HOLE \_\_\_\_\_

ABANDONED \_\_\_\_\_

DATE

NOV 21 1928

192

S. J. LEWIS

SCOUT

*Geological*  
K13 KANSAS

MAP NO. \_\_\_\_\_ SEC. 15 TWP. 26 R. 11

WELL NO. 1 Lot 83

T. W. Flake & Dal COMPANY

CONTRACTOR

SECTION PLAT


\_\_\_\_\_ FT. FROM N. LINE

830 FT. FROM S. LINE

200 FT. FROM E. LINE

\_\_\_\_\_ FT. FROM W. LINE

CORRECTION

LOCATION \_\_\_\_\_

RIG UP \_\_\_\_\_

DRILLING AND REMARKS:

*Reported  
N.E. S.E.S.E.*

RECORD

CASED \_\_\_\_\_ IN., \_\_\_\_\_ FT.

SAND \_\_\_\_\_

GAS \_\_\_\_\_

OIL \_\_\_\_\_

TOTAL DEPTH \_\_\_\_\_

PRODUCTION

1ST 24 HRS. NAT. \_\_\_\_\_

1ST 24 HRS. AFTER SHOT \_\_\_\_\_

GAS \_\_\_\_\_ CU. FT.

DRY HOLE \_\_\_\_\_

ABANDONED \_\_\_\_\_

DATE

8761 8 2 AON 192

S. J. LEWIS SCOUT

Map No. KANSAS Sec. 18 Twp. 26 R. 1E

Well No. 1 204 83

J. V. Flake & Co. Company

Contractor

SECTION PLAT

..... Ft. from N. Line

330 Ft. from S. Line

200 Ft. from E. Line

..... Ft. from W. Line


ABANDONED

Location.....

Rig up.....

Drilling and Remarks:

Dry

RECORD

Cased..... in., ..... ft.

Sand.....

Gas.....

Oil.....

Total Depth 1965

PRODUCTION

1st 24 hrs. Nat.....

1st 24 hrs. after shot.....

Gas..... Cu. Ft.

Dry Hole.....

Abandoned.....

Date

MAY 29 1929

192

S. J. LEWIS Scout