

KANSAS


FORM 51 5M 10-41 PETROL

Barton

Section 35 Township 18 Range 13-W

Well No. #1 Bates

Company Bay Petroleum

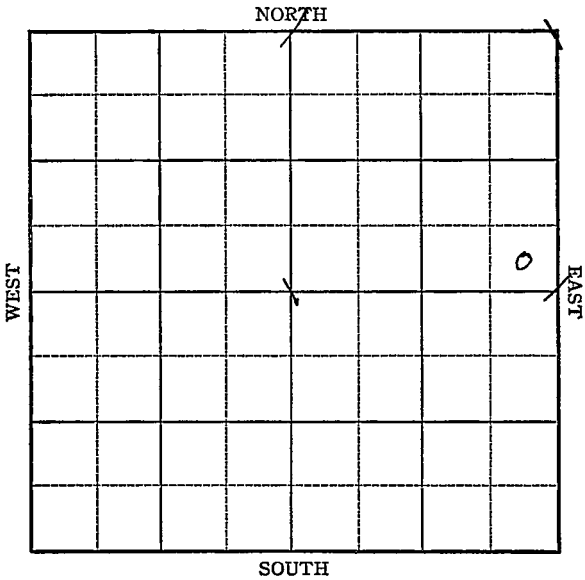

KANSAS

Barton

Sec. 35 Twp. 18 R. 13-W

Well No. #1 Bates Farm

Ray Petroleum Company


Wildcat

 Ft. from N. Line

330 Ft. from S. Line

330 Ft. from E. Line

 Ft. from W. Line

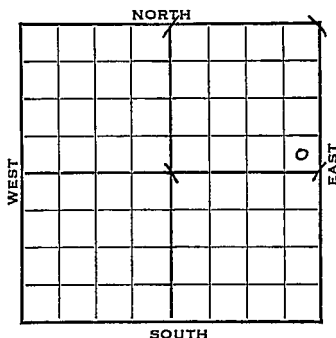

Wildcat Elev. 1797

1943

REPORT

1/13

Spud

1/20

Anhy 670'
8" Casing set 680
Drlg. 1800'.

1/27

Drlg. 2885'

2/3

Lans 3089
B KC 3312
Congl 3329
Arb. 3346
T.D. 3375'
No shows.

ABANDONED


Barton

KANSAS

Map No. 72 Sec. 35 Twp. 18 R. 13WWell No. 1 BatesBay Petroleum CompanyFIRST REPORT Contractor

SE NE

SECTION PLAT

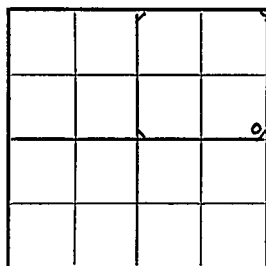 Ft. from N. Line330 Ft. from S. Line330 Ft. from E. Line Ft. from W. Line

WILDCAT

Location Rig up

Drilling and Remarks:

Spud

RECORD

Cased in., ft.Sand Gas Oil Total Depth

PRODUCTION

1st 24 hrs. Nat. 1st 24 hrs. after shot Gas Cu. Ft.Dry Hole Abandoned

Date

JAN 13 1913 19 S. J. LEWIS Scout

Barton

KANSAS 3

Map No. 3 Sec. 35 Twp. 18 R. 13WWell No. 1 BatesBay Petroleum


Company

ABANDONED

Contractor

SE NE

SECTION PLAT

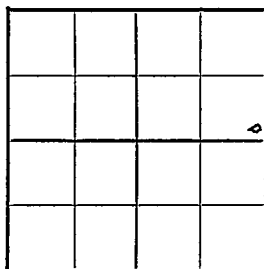 Ft. from N. Line330 Ft. from S. Line330 Ft. from E. Line Ft. from W. Line

WILDCAT

Location Rig up

Drilling and Remarks:

*Lane 3089**BHC 3312**Cong 3329**CE 3346**Noe hole*

RECORD

Cased in., ft.Sand Gas Oil Total Depth 3375

PRODUCTION

1st 24 hrs. Nat. 1st 24 hrs. after shot Gas Cu. Ft.Dry Hole Abandoned

Date

FEB 3 1943

19

S. J. LEWIS Scout