


Barton

KANSAS

Section 30 Township 20 Range 12W

Well No. #1 Walsh

Company Sterling Drlg.

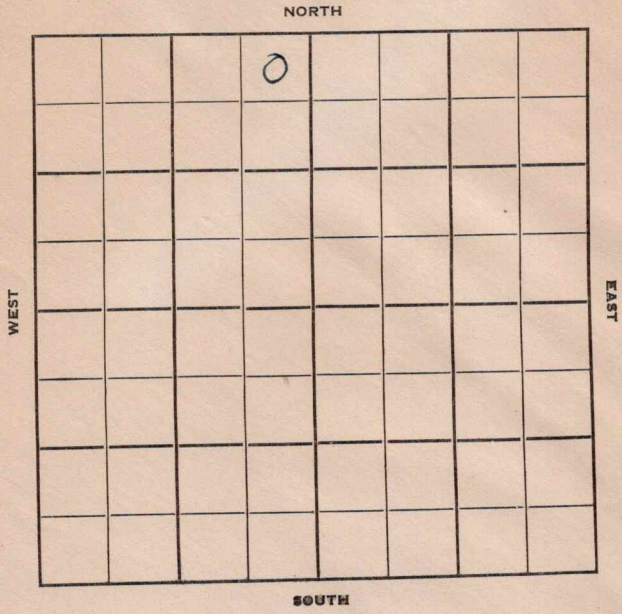

KANSAS

Sec. 30 Twp. 20 R. 12-W

Well No. #1 Walsh Farm ☒

Sterling Drlg.

Company

Contractor

Wildcat

330

Ft. from N. Line

Ft. from S. Line

330

Ft. from E. Line


Ft. from W. Line

NE NE NW

Sohio DHM

British American Farmout

NORTH

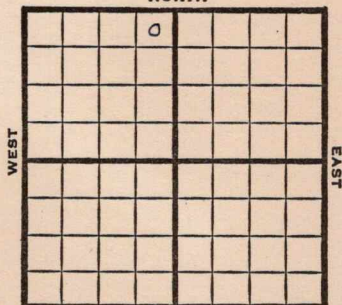

SOUTH

1950

Elev 1850' REPORT

9/13

Drlg.

1951

1/17

Spud 9-12-50

8" @ 280

Heeb 3067

Br lime 3189

Lans 3206

Cong 3444

Arb 3464

SO 3469-72

5" @ 3469

TD 3489

B/3 goph 500 A

B/1½ boph 1000 A

S/4 boph went to water

D&A

ABANDONED

County Barton State Kansas

Sec. 30 (Blk.) 20 (Sur.) 12W Map No.

Operator Sterling Drlg.

Well No. 1 Farm Walsh

[illegible]

0

FIRST REPORT

1

330 Ft. From N Line NW

330 Ft. From E Line Quarter

1st. Report SEP 13 1950

Completion

Remarks Sohio DEM

British-American farmout


Spudding Date _____

Drig. Data Wildcat

drum.

J. E. TYRA

County Barton State Kansas
 Sec. 30 (Blk. 20 (Sur. 12W Map No.
 (Twp.) (Rge.)
 Operator Sterling Drlg.
 Well No. 1 Farm Walsh
 Elev. 1850 Location NE NE NW

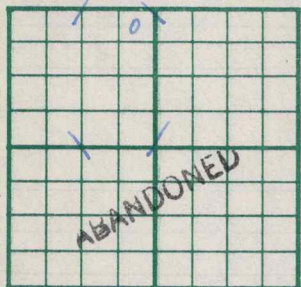

330 Ft. From N Line NW
330 Ft. From E Line Quarter
 1st. Report
 Completion JAN 17 1951
 Remarks Wildcat

Spudding Date 9-12-50

Drlg. Data D & A TD 3489
8" @ 280 Heeb. 3067 Br. lime 3189
Lans. 3206 Cong. 3444 Arb. 3464
SO 3469-72 5" @ 3469 TD 3489
B/ 3 goph 500 A B/ 1½ boph 1000A
S/ 4 boph went to water
D & A

J. E. TVDA