


Section 30 Township 20 Range 12 W
Well No. # 1 Welsh
Company Virginia Drlg.

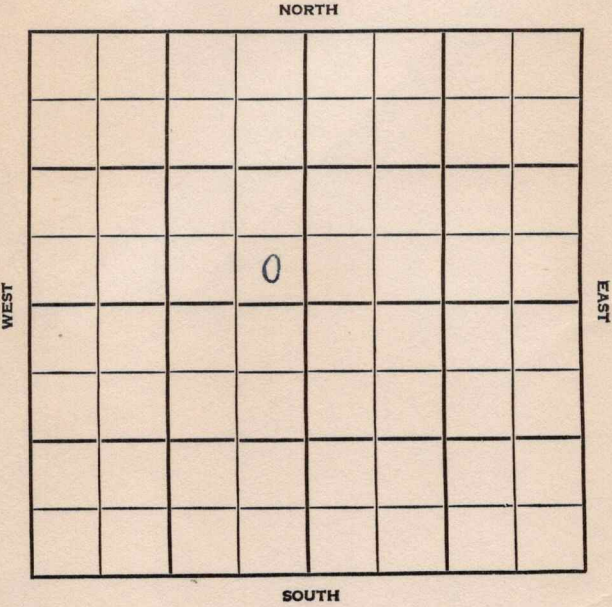

Barton

KANSAS

SEC.	TWP.	R.
30	20	12W

WELL NO.

#1 Welsh

FARM

Virginia Drlg.

CONTRACTOR

Co. Tools.

E. Rolling Green Pool


Ft. from N. Line

330 Ft. from S. Line

330 Ft. from E. Line

Ft. from W. Line

SE SE NW

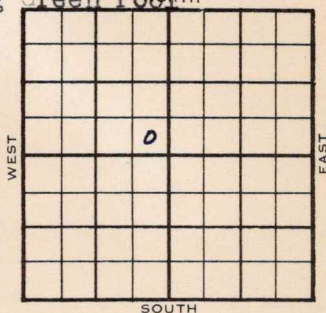

	ELEVATION	REPORT
1955	1860'	

3/16 R U R

4/13 Spud 3-29-55 - D&A

TD 3550'

8" @ 243'

Anhy 690', Heeb. 3087', Br lime
3210', Lans. 3226'DST 3275-3310', opn 32", rec. 540'
mud, 12#

Ch. Cong. 3464', Ch. Viola 3470'

DST 3444', 3500', opn 15", rec. 5'
mud, 80#


Simp. sh 3500', Arb. 3536'

TD 3550'

D&A

ABANDONED

County Barton State Kansas
 Sec. 30 (Blk.) 20 (Sur.) 12W Map No.
 (Twp.)
 Operator Virginia Drlg.
 Well No. 1 Farm Welsh
 Elev. Location SE SE NW

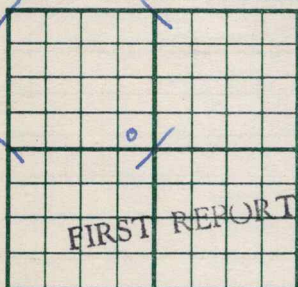

330 Ft. From S Line NW

330 Ft. From E Line Quarter

1st. Report MAR 1 6 1955

Completion

Remarks

Co. tools


Spudding Date

Drlg. Data E. Rolling Green Pool

R U R

FABEN GILSTRAP

County Barton State Kansas
 Sec. 30 (Blk.) 20 (Sur.) 12W Map No.
 Operator Virginia Drlg.
 Well No. 1 Farm Welsh
 Elev. 1860 Location SE SE NW

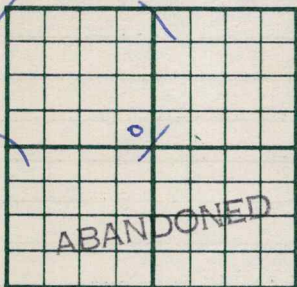

330 Ft. From S Line NW
330 Ft. From E Line Quarter

1st. Report

Completion APR 13 1955

Remarks E. Rolling Green Pool

Co. tools

Spudding Date 3-29-55

Drlg. Data D & A TD 3550

8" @ 243 Anhy 690 Heeb. 3087

Br. lime 3210 Lens. 3226 DST 3275-3310

open 32 min. Rec. 540' mud 12#

Ch. Cong. 3464 Ch. Viola 3470 DST 3444-

3500 open 15 min. Rec. 5' mud 80#

Simp. sh. 3500 Arb. 3536 TD 3550

D & A

FABEN GILSTRAP