


Map No. Kans Sec. 4 Twp. 30 R. 8
Well No. 5 Maunah Farm
C. E Roth Company

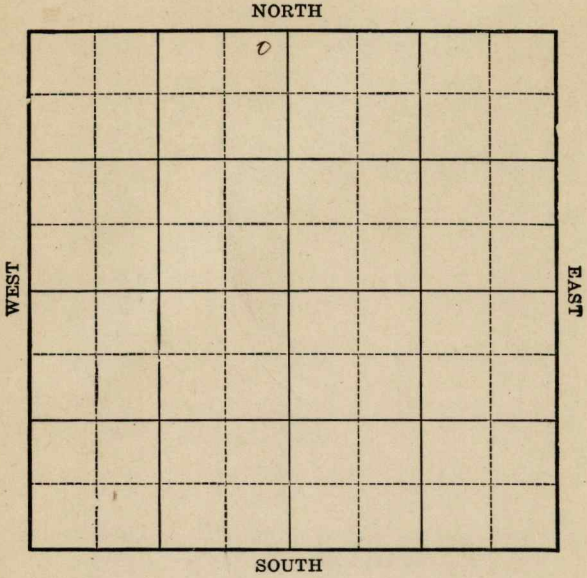

Location _____
Drilling Remarks _____

Rig Up _____
Drilling Remarks _____

RECORD

Cased _____ in. _____ ft.
Sand _____
Gas _____
Oil _____
Total Depth _____

PRODUCTION


1st 24 hrs. Nat. _____
1st. 24 hrs. after shot _____
Gas _____ cu. ft.
Dry Hole _____
Abandoned _____

Map No. Kansas Sec. 4 Twp. 30 R. 8Well No. X Hannah FarmC. E. Roth Company264 Ft. from N. Line

Ft. from S. Line

264 Ft. from E. Line

Ft. from W. Line

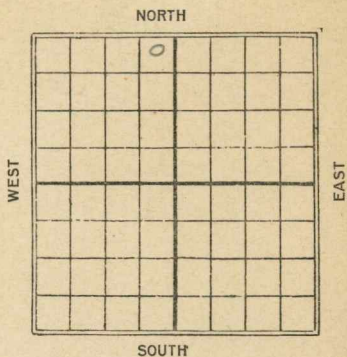Date
1925

REPORT

3/1 R.O.G.4/24 2082-2115 120 gals
50 Bbls

Map No. 10 KANSAS Sec. 4 Twp. 30 R. 8Well No. 5 NannahO. E. Roth Company4 Contractor

SECTION PLAT

	0		

FIRST REPORT

264 Ft. from N. Line

_____ Ft. from S. Line

264 Ft. from E. Line

_____ Ft. from W. Line

Location _____

Rig up _____

Drilling and Remarks:

R.O.G.

{ Correction
 Change from
 # 4 to # 5.
 Saw

RECORD

Cased _____ in., _____ ft.

Sand _____

Gas _____

Oil _____

Total Depth _____

PRODUCTION

1st 24 hrs. Nat. _____

1st 24 hrs. after shot _____

Gas _____ Cu. Ft.

Dry Hole _____

Abandoned _____

Date

3/1 1925A. BENFAR Scout

Map No. 10 1/2 Sec. 4 Twp. 30 R. 8

Well No. 5 Hannah

C. E. Roth Company

Contractor

COMPLETED

SECTION PLAT

264 Ft. from N. Line

Ft. from S. Line

264 Ft. from E. Line

Ft. from W. Line

Location

Rig up

Drilling and Remarks:

RECORD

Cased 2082-2115 in., ft.

Sand

Gas

Oil

Total Depth

PRODUCTION

1st 24 hrs. Nat.

1st 24 hrs. after shot

Gas Cu. Ft.

Dry Hole

Abandoned

Date

APR 24 1925

192

Chas. L. Sherwood Scout

Benear -

this well formerly
reported in NE-NE. sec-

4-30-8 - please

advise if this is
correction and if
this is the only well
on this tract.

RECORD	Location
Cased in	
Sand	
Gas	
Oil	
Total	
Returned	Run
Cards	Run
Tracing	Run
J. S. C. map	Run
Gas test map	Run
Moody map	Run
Gas plat book	
Moody plat book	