

Barton

KANSAS

SECTION 31 TOWNSHIP 20 RANGE 12 W

WELL NO. #1 Tammen

COMPANY Hulme Drlg.

NORTH

				0			
WEST							EAST

SOUTH

Barton

KANSAS

SEC. 31	TWP. 20	R. 12 W
------------	------------	------------

WELL NO. #1 Tammen FARM

COMPANY Hulme Drlg.

CONTRACTOR Co. Tools


E. Rolling Green

_____ Ft. from N. Line

_____ Ft. from S. Line

_____ Ft. from E. Line

_____ Ft. from W. Line

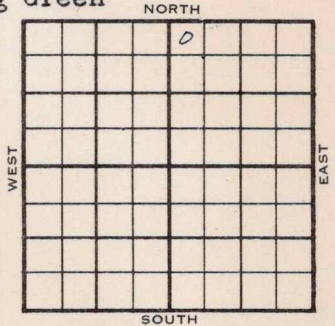

NW NW NE

1956	ELEVATION 1856'	REPORT
------	--------------------	--------

1-25 Comm. 1-17-56
8" set
Drlg. 3000

3-14 5½" @ 3461
DST 3220-80 @p 20 min, rec. 240' hocm
385#
DST 3360-3402 op 20 min, rec. 90'
hocm, 825#
CO to 3462, 500 A
S/ 10 goph,
DD 3471, 2000 A
S/ 4 boph
Comp. 25 bopd
Anh. 670
H. 3079
BL. 3202
L. 3218
C. 3443
A 3459
TD 3462

COMPLETED

County Barton Elev. 1856
 Sec. 31 Twp. 20 Rge. 12W
 Company Hulme Drlg.
 Farm Name Tammen No. 1

TOPS	DEPTH	LOG	DATUM
Anh.			
TP.			
H.			
Tr.			
Dg.			
BL.			
L.			
K.C.			
B.K.C.			
Ce.			
C.			
M.			
M.			
K.			
Mz.			
Me.			
V.			
S.			
S.			
A			
R.			
PE.			
G.			
T.D.			

Loc. in Sec. NW NW NE
 Geol. _____
 Contr. Co. tools
 Pool E. Rolling Green
 FIRST REPORT
 JAN 25 '56

Date Comm. 1-17-56
8" set drlg. 3000

(Large red scribble)

Co.
Lsc.
No.
Sec.
T.
R.

County Barton Elev. 1856
 Sec. 31 Twp. 20 Rge. 12W
 Company Hulme Drlg.
 Farm Name Tammen No. 1

TOPS	DEPTH	LOG	DATUM	Loc. in Sec.									
Anh.	<u>670</u>			NW NW NE									
TP.													
H.	<u>3079</u>												
Tr.													
Dg.													
Bl.	<u>3202</u>												
L.	<u>3218</u>		<u>1362</u>	Geol.									
K.C.				Contr.									
B.K.C.				Co. tools									
Ce.				Pool									
C.	<u>3443</u>		<u>1587</u>	E. Rolling Green									
M.				<table border="1"> <tr> <td></td> <td></td> <td>0</td> </tr> <tr> <td colspan="3" style="text-align: center;">COMPLETE</td> </tr> <tr> <td></td> <td></td> <td></td> </tr> </table>			0	COMPLETE					
		0											
COMPLETE													
M.													
K.													
Mz.													
Ma.													
V.													
S.													
S.													
A	<u>3459</u>		<u>1603</u>										
R.													
Pe.													
G.													
T.D.	<u>3462</u>												

Date Comm. 1-17-56 MAR 14 1956

8" @ 5 $\frac{1}{2}$ " @ 3461 DST 3220-80
 open 20 min. rec. 240' hocm 385#
 DST 3360-3402 open 20 min. rec. 90'
 hocm 825# CO to 3462 500 A
 S/ 10 goph DD 3471 2000 A
 S/ 4 boph Comp. 25 bopd