

Barton

KANSAS
12W

SECTION 31 TOWNSHIP 20 RANGE

WELL NO. #3 Tammen

COMPANY Chas Hulme Drlg

NORTH

				0			

WEST

EAST

SOUTH

Barton

KANSAS

SEC.	TWP.	R.
31	20	12W

WELL NO.

#3 Tammen

FARM

COMPANY

Chas. Hulme Drlg.

CONTRACTOR

Co. Tools

B. Rolling Green


Ft. from N. Line

Ft. from S. Line

Ft. from E. Line

Ft. from W. Line

SW NW NE

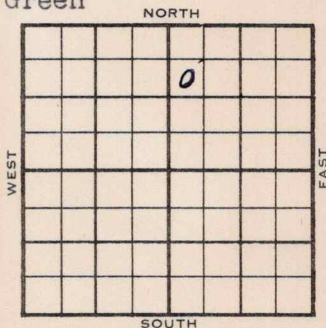

	ELEVATION	REPORT
1956	1854'	
4-11	Location	
6-6	Comm. 4-11-56 8 5/8" @ 226 w/300 5 1/2" @ 3463 DD 3474 P/ 1 1/2 boph, no/wtr. P/ 20 BOPD, no/wtr. Anh. 865', H. 3078', BL. 3202', L. 3217 C. 3441', A. 3461', TD 3465'	

COMPLETED

County Barton Elev. 12W
Sec. 31 Twp. 20 Rgs. 12W
Company Chas. Hulme Drig.
FarmName Tamen No. 3

TOPS	DEPTH	LOG	DATUM	Loc. in Sec.
Anh.				SW NW NE
TP.				
H.				
Tr.				
Dg.				
BL.				
L.				Geol.
K.C.				Contr.
B.K.C.				Co. tools
Ce.				Pool
C.				E. Rolling Green
M.				
M.				
K.				
Mz.				
Me.				
V.				
S.				
S.				
A.				
R.				
Pe.				
G.				
T.D.				

Date Comm. Location

APR 1 7 1955

R. G.

County

~~Barton~~

Elev.

1854

Sec.

31

Twp.

~~20~~

Rgs.

12W

Company

Chas. Hulme Drlg.

Farm Name

Tammen

No.

3

TOPS	DEPTH	LOG	DATUM	Loc. in Sec.
Anh.	665			SW NW NE
Tr.	3078			
H.				
Tr.				
Dg.				
BL.	3202			
L.	3217			Geol.
K.C.				Contr.
B.K.C.				Co. tools
Ce.	3441			Pool
C.				E. Rolling Green
M.				
M.				
K.				
Mz.				
Ma.				
V.				
S.				
S.	3461			
A.				
R.				
Pe.				
G.				
T.D.	3465			

COMPLETE

Date Comm.

JUN 6 1956

Location

APR 18 '56

4-17-56 85/8

226/300

10 2750

APR 25 '56

5 1/2 @

3463/

MAY 2 '56

Tite

MAY 9 '56

MAY 16 '56

DD 3474 TD

2 1/2

P. 1 1/2 Boph

no/wt

MAY 23 '56

MAY 29 '56

JUN 6 '56

p 20 BOPD

NW.