

Map No. KANSAS Sec. 28 Twp. 26 R. 1E


Well No. 1- Armstrong Farm
Twist et al Company

330 Ft. from N. Line

_____ Ft. from S. Line

330 Ft. from E. Line

_____ Ft. from W. Line

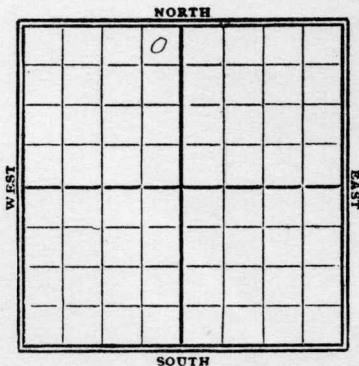

1929

Date	REPORT
3/27	Bldy Rig
4/10	Spud
4/17	S.O. 9/4
4/24	— 9/11
5/1	— 9/18 Spudded
5/8	— & Abandoned
5/15	—
5/22	—
5/29	—
6/5	—
6/12	—
6/19	—
6/26	—
7/2	—
7/10	—
7/17	—
7/24	—
7/31	—
8/7	—
8/14	—
8/21	—
8/28	—

Map No. **KANSAS** Sec. **28** Twp. **26** R. **1E**

Well No. **1 Armstrong**

Twist & Dal Company

Contractor

SECTION PLAT

330 Ft. from N. Line

Ft. from S. Line

330 Ft. from E. Line

Ft. from W. Line

FIRST REPORTS

Location.....

Rig up.....

Drilling and Remarks:

Building rig

RECORD

Cased.....in.,ft.

Sand.....

Gas.....

Oil.....

Total Depth.....

PRODUCTION

1st 24 hrs. Nat.....

1st 24 hrs. after shot.....

Gas.....Cu. Ft.

Dry Hole.....

Abandoned.....

Date

MAR 27 1929

S. J. LEWIS

192.....

Scout

Map No. *13* **KANSAS** Sec. *28* Twp. *26* R. *1E*

Well No. *1 Armstrong*

Stewart & Co Company

Contractor


SECTION PLAT

330 Ft. from N. Line

..... Ft. from S. Line

330 Ft. from E. Line

..... Ft. from W. Line

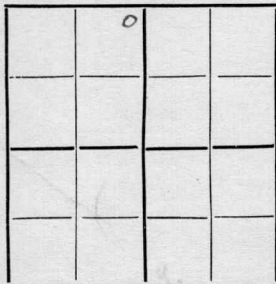

ABANDONED

Location.....

Rig up.....

Drilling and Remarks:

Spud

RECORD

Cased.....in.,ft.

Sand.....

Gas.....

Oil.....

Total Depth.....

PRODUCTION

1st 24 hrs. Nat.....

1st 24 hrs. after shot.....

Gas.....Cu. Ft.

Dry Hole.....

Abandoned *Loc*

Date

SEP 18 1929

192.....

S. J. LEWIS

Scout