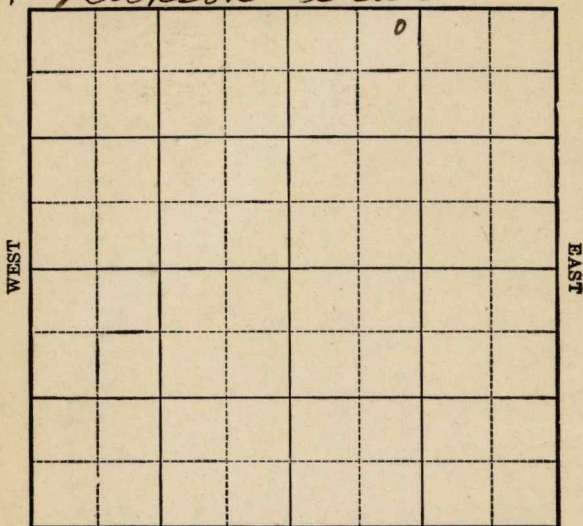


Map No. Kansas Sec. 5 Twp. 30 R. 8Well No. 1 Hagoner Farm~~Hagoner et al~~ CompanyE. Hickson et al NORTH

Location _____

Drilling Remarks:

Rig Up _____

Drilling Remarks:

RECORD

Cased _____ in. _____ ft.

Sand _____

Gas _____

Oil _____

Total Depth _____

PRODUCTION

1st 24 hrs. Nat. _____

1st 24 hrs. after shot _____

Gas _____ cu. ft.

Dry Hole _____

Abandoned _____

10 *1000* Map No. *5* Sec. *30* Twp. *8* R.

Well No. *1 Wagoner*

Wagoner Company

Contractor

FIRST REPORTS

SECTION PLAT

300 Ft. from N. Line

Ft. from S. Line

Ft. from E. Line

1000 Ft. from W. Line

		<i>0</i>	

Location

Rig up *✓*

Drilling and Remarks:

RECORD

Cased in., ft.

Sand

Gas

Oil

Total Depth

PRODUCTION

1st 24 hrs. Nat.

1st 24 hrs. after shot

Gas Cu. Ft.

Dry Hole

Abandoned

Date APR 24 1925 *Chas L. Sherwood* Scout

Map No. 10 S. 5 Sec. 5 Twp. 30 R. 8

Well No. 1 Wagoner

ERICKSON of #4 Company

Contractor

CORRECTION

SECTION PLAT

300

_____ Ft. from N. Line

_____ Ft. from S. Line

_____ Ft. from E. Line

1070

_____ Ft. from W. Line

		0	

CORRECTION

Location _____

Rig up _____

Drilling and Remarks:

S/D 1700'

chg owner ship
to above.

RECORD

Cased _____ in., _____ ft.

Sand _____

Gas _____

Oil _____

Total Depth _____

PRODUCTION

1st 24 hrs. Nat. _____

1st 24 hrs. after shot _____

Gas _____ Cu. Ft.

Dry Hole _____

Abandoned _____

Date

MAY 29 1925

192

CHAS. L. SHERWOOD

Scout

Map No. 10 15th Sec. 5 Twp. 30 R. 8

Well No. 1 Wagoner
Blackson & Co Company

Contractor

COMPLETED

SECTION PLAT

300 Ft. from N. Line

_____ Ft. from S. Line

_____ Ft. from E. Line

1620 Ft. from W. Line

ABANDONED

		0	

Location _____

Rig up _____

Drilling and Remarks:

Dry & hho

LD 2135'

RECORD

Cased _____ in., _____ ft.

Sand _____

Gas _____

Oil _____

Total Depth 2135'

PRODUCTION

1st 24 hrs. Nat. _____

~~1st~~ 24 hrs. after shot _____

Gas _____ Cu. Ft.

Dry Hole ☒

Abandoned ☒

Date

JUL 10 1925

192

CHAS. L. SHERWOOD

Scout