


Map No. Raus Sec. 5 Twp. 30 R. 8^EWell No. 1 Wagoner Farm
J. E. Miller and Prairie O & H. Company

NORTH

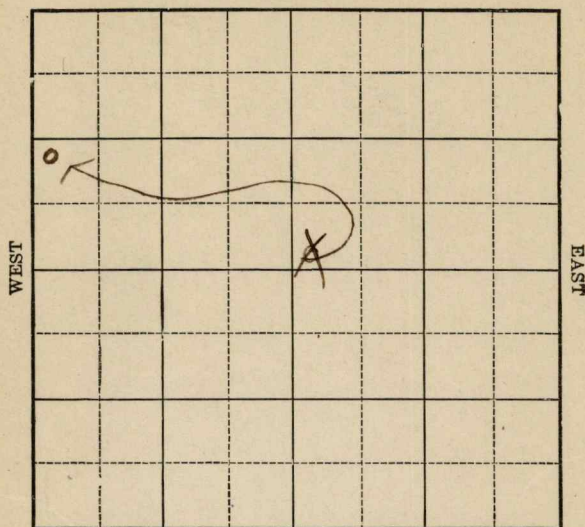

SOUTH

Location _____

Drilling Remarks _____

RECORD

Cased _____ in. _____ ft.

Sand _____

Gas _____

Oil _____

Total Depth _____

Rig Up _____

Drilling Remarks _____

PRODUCTION

1st 24 hrs. Nat. _____

1st. 24 hrs. after shot _____

Gas _____ cu. ft.

Dry Hole _____

Abandoned _____

Map No. Kansas Sec. 5 Twp. 30 R. 8 EWell No. 1 Wagoner Farm
J.E. Miller & Prairie Company


Ft. from N. Line

1020
~~500~~ Ft. from S. Line

Ft. from E. Line

300 Ft. from W. Line

NORTH

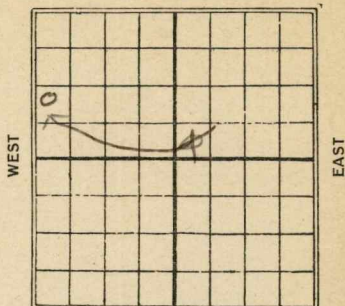

SOUTH

C.

Date

REPORT

19254/10 Timbers5/29 Dry 19606/5 ✓ 24206/12 Running 6" 27206/19 Top lime. 2710 Running 6"
@ 27206/26 2880 S.D.7/37/10 TD. 3163 Dry & Abandoned

Map No. *10 Kansas* Sec. *5* Twp. *30* R. *8* ^{E.}

Well No. *1 Wagoner*
J. E. Miller and Prairie Oil & Gas Co. Company

Contractor

FIRST REPORTS

SECTION PLAT

Ft. from N. Line

200 Ft. from S. Line

Ft. from E. Line

300 Ft. from W. Line

		0	

Location

Rig up

Drilling and Remarks:

Timbers

RECORD

Cased _____ in., _____ ft.

Sand _____

Gas _____

Oil _____

Total Depth _____

PRODUCTION

1st 24 hrs. Nat. _____

1st 24 hrs. after shot _____

Gas _____ Cu. Ft.

Dry Hole _____

Abandoned _____

Date

APR 10 1925

192

Chas. L. Shewood Scout

Map No. 10 10th St Sec. 5 Twp. 30 R. 8
 Well No. 1 Wagoner
2 E Miller & L. Miller of D Company

Contractor

CORRECTION


SECTION PLAT

Ft. from N. Line

1020 Ft. from S. Line

Ft. from E. Line

300 Ft. from W. Line

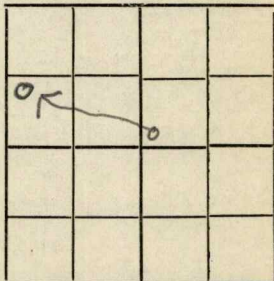

Location

Rig up

Drilling and Remarks:

only 455'

CORRECTION

chg location

RECORD

Cased _____ in., _____ ft.

Sand _____

Gas _____

Oil _____

Total Depth _____

PRODUCTION

1st 24 hrs. Nat. _____

1st 24 hrs. after shot _____

Gas _____ Cu. Ft.

Dry Hole _____

Abandoned _____

Date

APR 24 1925

192

Chas. L. Sherwood

Scout

Map No. 1544 Sec. 5 Twp. 30 R. 8Well No. 1 WagonerL. E. Miller & Maudie O. R. Company

Contractor

COMPLETED

SECTION PLAT

Ft. from N. Line

1020 Ft. from S. Line

Ft. from E. Line

300 Ft. from W. Line

ABANDONED

Location

Rig up

Drilling and Remarks:

Tap line 2721'Dry & abd.20 3163'

RECORD

Cased _____ in., _____ ft.

Sand _____

Gas _____

Oil _____

Total Depth 3163'

PRODUCTION

1st 24 hrs. Nat. _____

1st 24 hrs. after shot _____

Gas _____ Cu. Ft.

Dry Hole ☒Abandoned ☒

Date

JUL 10 1925

192

CHAS. L. SHERWOOD

Scout