


Section 32 Township 20 Range 12WWell No. #1 DeWerffCompany Victor Drlg.

NORTH

WEST

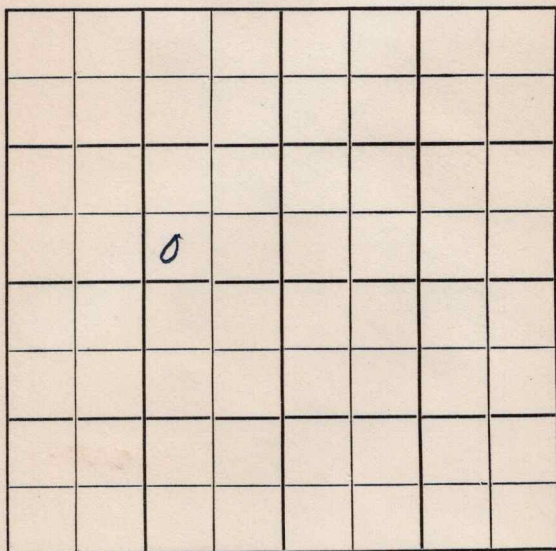

EAST

SOUTH

Barton

KANSAS

Sec. 32 Twp. 20 R. 12 W

Well No. # 1 DeWerff Farm

Victor Drlg. Company

Contractor

Wildcat

Ft. from N. Line


330 Ft. from S. Line

990 Ft. from E. Line

Ft. from W. Line

SW SE NW

Stanolind Farmout

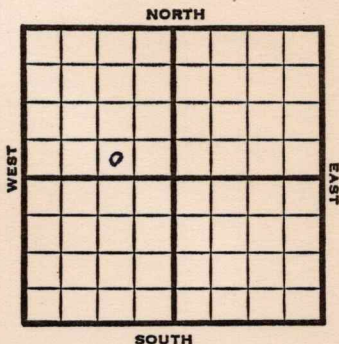

1952

Elev. 1851' REPORT.

1/2

Spud 12-24-51
8" @ 239'
Drlg. 2760'

1/9

Spud 12-24-51
D&A TD 3515
8" @ 239
Br lime 3189 Lans. 3203
Cong. 3431 Arb. 3466
DST 3473-85 opn 1 hr. Rec. 15' wcm
TD 3515
D&A

ABANDONED

County Barton State KansasSec. 32 (Blk.
Twp.) 20 (Sur.
Rge.) 12W Map No.Operator Victor Drlg.Well No. 1 Farm DeWerffElev. Location SW SE NW


FIRST REPORT

330 Ft. From S Line NW990 Ft. From E Line Quarter1st. Report JAN 2 1952

Completion

Remarks Stanclind farmoutSpudding Date 12-24-51Drlg. Data Wildcat8" @ 239 drlg. 2760

J. E. TYRA

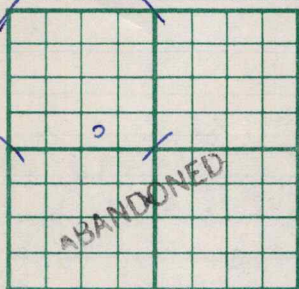County Barton State KansasSec. 32 (Blk.
Twp.) 20 (Sur.
Rge.) 12W Map No.Operator Victor Drlg.Well No. 1 Farm DeWerffElev. 1851 Location SW SE NW330 Ft. From S Line NW990 Ft. From E Line Quarter

1st. Report

Completion JAN 9 1952Remarks WildcatSpudding Date 12-24-51Drlg. Data D & A TD 35158" @ 239 Br. lime 3189 Lans. 3203Cong. 3431 Arb. 3466 DST 3473-85open 1 hr. Rec. 15' wcm TD 3515D & A

J. E. TYRA