


Barton

KANSAS

SECTION 33 TOWNSHIP 20 RANGE 12 W

WELL NO. #1 Kaselman

COMPANY Duke

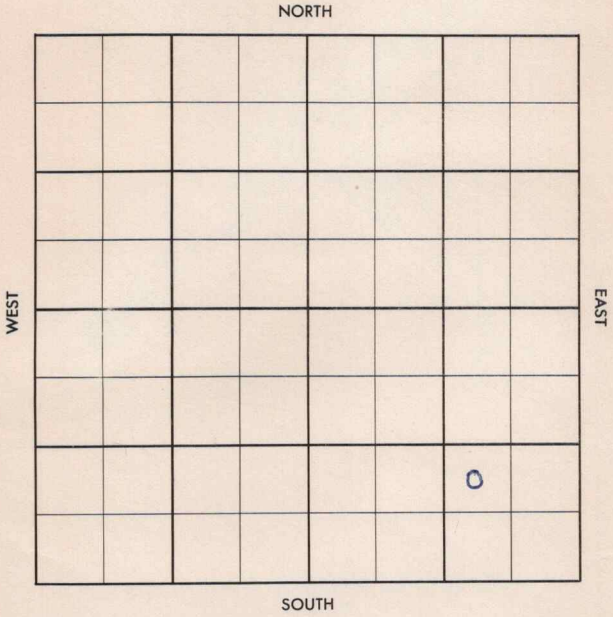

Barton

KANSAS


SEC. 33	TWP. 20	R. 12W
------------	------------	-----------

WELL NO. #1 Kaselman FARM  
COMPANY

CONTRACTOR # Duke  
Co. Tools

Chase-Silica

\_\_\_\_\_ Ft. from N. Line  
\_\_\_\_\_ Ft. from S. Line  
\_\_\_\_\_ Ft. from E. Line  
\_\_\_\_\_ Ft. from W. Line

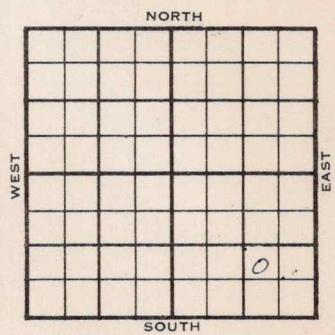

NW SE SE

	ELEVATION	REPORT
1956	1830	
1-25	Comm. 1-16-56 8" @ 250 WOC	
3-14	DST 3270-3300 op 1 hr. 20 min, rec. 45' gcm, 240# DST 3318-34 op 80 min, rec. 65' so&gcm 790# 5 1/2" @ 3404/100 DD 3420 S/ 25 boph, 1500 A, S/ 3 boph 2 hrs. SP 3360, 20/ 3322-37, 3500 A S/ 3 boph 8 hrs. Comp. 25 bopd H. 3017 BL. 3146 L. 3163 A. 3401 TD 3406'	

COMPLETED

County Barton Elev. \_\_\_\_\_  
 Sec. 33 Twp. 20 Rge. 12W  
 Company Duke  
 Farm Name Kaselman No. 1

TOPS	DEPTH	LOG	DATUM	Loc. in Sec.
Anh.				NW SE SE
Tp.				
H.				
Tr.				
Dg.				
Bl.				
L.				
K.C.				Geol. _____
B.K.C.				Contr. _____
Ce.				Co. tools
C.				
M.				Pool
M.				Chase-Silica
K.				
Mz.				
Me.				
V.				
S.				
S.				
A.				FIRST REPORT
R.				
PE.				JAN 25 '58
G.				
T.D.				

Date Comm. 1-16-56  
8" @ 250 WOC

~~13~~

Co.  
 Use.  
 No.  
 Sec.  
 T.  
 R.

County Barton Elev. 1830  
 Sec. 33 Twp. 20 Rge. 12W  
 Company Duke Drlg.  
 FarmName Kaselman No. 1

TOPS	DEPTH	LOG	DATUM
Anh.			
TP.			
H.	<u>3017</u>		
Tr.			
Dg.			
B.L.	<u>3146</u>		
L.	<u>3163</u>		<u>1333</u>
K.C.			
B.K.C.			
Ce.			
C.			
M.			
M.			
K.			
Mz.			
Ma.			
V.			
S.			
S.			
A.	<u>3401</u>		<u>1571</u>
R.			
PE.			
G.			
T.D.	<u>3406</u>		

Loc. in Sec. NW SE SE  
 Geol. \_\_\_\_\_  
 Contr. \_\_\_\_\_  
 Co. tools \_\_\_\_\_  
 Pool \_\_\_\_\_  
 Chase-Silica \_\_\_\_\_



Date Comm. 1-16-56 MAR 1 4 1956

8" @ 250 DST 3270-3300 open 1 hr. 20 mi  
 rec/ 45' gcm 240# DST 3318-34  
 open 80 min. rec. 65' so & gcm 790#  
 5 1/2" @ 3404/100 DD 3420 S 25 goph  
 1500 A S/ 3 boph 2 hr. SP 3360  
 20/ 3322-27 3500 A S/ 3 boph 8 hr.  
 Comp. 25 bopd