


Sedgwick

KANSAS

SECTION 34 TOWNSHIP 26 RANGE 1E

WELL NO. #1 Lee

COMPANY E.H. Adair Oil Co.

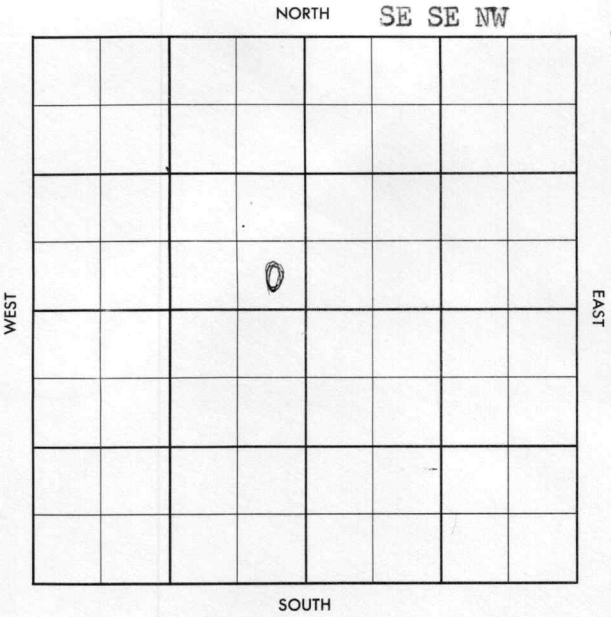

County Sedgwick Elev. _____
 Sec. 34 Twp. 26 Rge. 1E
 Company E. H. Adair Oil Co.
 Farm Name Lee No. 1

TOPS	DEPTH	LOG	DATUM	Loc. in Sec.
Anh.				SE SE NW
Tr.				
Dg.				
B.L.				
L.				Geol. _____
K.C.				
B.K.C.				Contr. _____
Ce.				
C.				
M.				
M.				Pool _____
K.				
Mz.				
Me.				
V.				
S.				
S.				
A.				
R.				
Pe.				
G.				
T.D.				

FIRST REPORT
 0
 MAR 6 '57

Date Comm. 3-5-57

Set surf pipe

29

Co.

Lse.

No.

Sec.

T.

R.

County Seogwick Elev. 1338
 Sec. 34 Twp. 26 Rge. 1E
 Company E. H. Adair Oil Co.
 FarmName Lee No. 1

TOPS	DEPTH	LOG	DATUM	Loc. in Sec.
Anh.				SE SE NW
TP.				
H.				
Tr.				
Dg.				
Bl.				
L.				Geol.
K.C.	2536			Contc
B.K.C.				
Ce.				
C.				
M.	3000			Pool
M.				
K.	3304			
Mz.				
Mo.				
V.	3373			ABANDONED
S. <u>sd</u>	3392			
S.				
A				
R.				
Pe.				
G.				
TD.	3410			MAR 20 '57

Date Comm. 3-5-57

Set surf pipe MAR 13 '57 8 3/4 244 / 165
 DST 2600 - 15 (30) 540' SW BHP
1140 (20) φ2785 MAR 20 '57

DEA

Co.
L.S.
No.
Sec.
T.
R.