
Sedgwick KANSAS

SECTION 34 TOWNSHIP 26 RANGE 1E

WELL NO. #2 Lee

COMPANY E.H. Adair

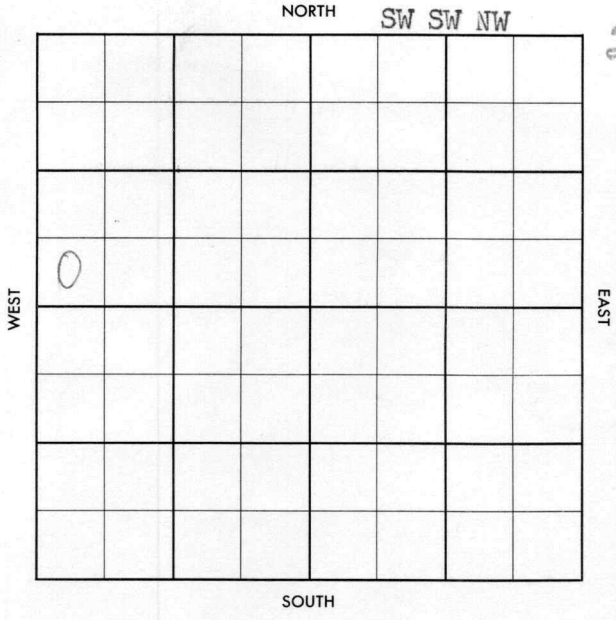

FORM 504-3 SUNRAY

FORM 513 SUNRAY

County Sedgwick Elev.

Sec. 34 Twp. 26 Rge. 1E

Company E. H. Adair

Farm Name Lee No. 2

TOPS	DEPTH	LOG	DATUM
Anh.			
Tp.			
H.			
Tr.			
Dg.			
B.L.			
L.			
K.C.			
B.K.C.			
Ce.			
C.			
M.			
M.			
K.			
Mz.			
Mo.			
V.			
S.			
S.			
A			
R.			
P€.			
G.			
T.D.			

Loc. in Sec. SW SW NW

Geol.

Contr. Co. Tools

Pool Wichita

FIRST REPORT

JUL 31 '57

Date Comm. 7-28-57

8" @ 250/175, Drlg. 931

Co. Lse. No. Sec. T. R.

FORM 513 SUNRAY

County Sedgwick Elev. 1323

Sec. 34 Twp. 26 Rge. 1E

Company E. H. Adair

Farm Name Lee No. 2

TOPS	DEPTH	LOG	DATUM
Anh.			
Tp.			
H.			
Tr.			
Dg.			
Bl.			
L.			
K.C.	2530		
B.K.C.	2692		
Ce.			
C.			
M. chert	3005		
M.			
K.	3284		
Mz.			
Mq.			
V.	3361		
S.	3381		
S.			
A	3461		
R.			
P€.			
G.			
T.D.	3472		

Loc. in Sec. SW SW NW

Geol.

Contr. Co. Tools

Pool Wichita

ABANDONED

AUG 14 57

Date Comm. 7-28-57

8" @ 250/175, Drlg. 931 AUG 8 '57 @ 3345

AUG 14 '57 DST 3412-26 op 45" 30' Md BHP 980/15" DST 3430-40 30" 10' Md BHP 1180/15

DEQ

Co. Lse. No. Sec. T. R.