
KANSAS

FORM 51 25M 3-49 PETROL Barton

Section 34 Township 20 Range 12W

Well No. #3 Foelgner

Company Champlin Ref. Co.

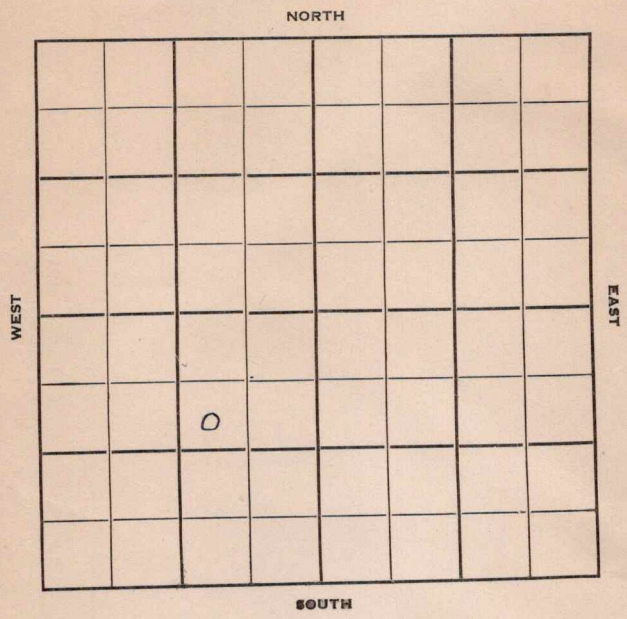

FORM 252-B
10M 11-50 PETROL

Barton KANSAS

Sec. 34 Twp. 20 R. 12W

Well No. #3 Foelgner Farm

Champlin Ref. Co. Company

Contractor

Bryant Pool


990' Ft. from N. Line

Ft. from S. Line

990' Ft. from E. Line

Ft. from W. Line

SW NE SW

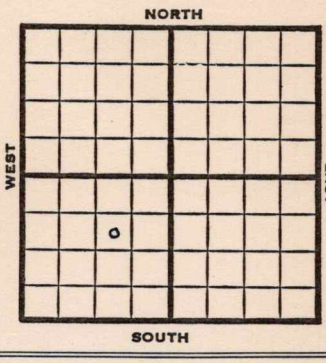


| 1951 | Elev. 1837' REPORT |
|---|---|
| 8/15 | Spud 8-9-51<br>8" @ 226<br>Anhy 770<br>Drlg. 2118' |
| 10/3 | Spud 8-9-51<br>Oil well TD 3415' 8" @ 226'<br>Anhy 770' Heeb. 3018' Base Oread 3054', Br. lime 3144' Lans 3161' Arb. 3391'<br>TD 3394' 5" @ 3391' DD 3399'<br>SSO DD 3402' B/2 GOPH 750 A<br>DD 3415' FU 1800' oil 16 hr. 750 A S/15 BOPD<br>Comp. 30 BOPD<br><br>COMPLETED |

FORM 275 FOR SALE BY KANSAS BLUE PRINT CO.

County Barton State Kansas

Sec. 34 (Blk. Twp.) 20 (Sur. Rge.) 12W Map No.

Operator Champlin Ref. Co.

Well No. 3 Farm Foelgner

Elev. Location SW NE SW




990 Ft. From N Line SW

990 Ft. From E Line Quarter

1st. Report AUG 15 1951

Completion

Remarks

Spudding Date 8-9-51

Drlg. Data Bryant Pool

8" @ 226 Anhy 770 drlg. 2118

J. E. TYRA

FORM 275 FOR SALE BY KANSAS BLUE PRINT CO.

County Barton State Kansas

Sec. 34 (Blk. Twp.) 20 (Sur. Rge.) 12W Map No.

Operator Champlin Ref.

Well No. 3 Farm Foelgner

Elev. 1837 Location SW NE SW




990 Ft. From N Line SW

990 Ft. From E Line Quarter

1st. Report

Completion OCT 3 1951

Remarks Bryant Pool

Spudding Date 8-9-51

Drlg. Data Oil well TD 3415

8" @ 226 Anhy 770 Heeb. 3018

Base Oread 3054 Br. lime 3144 Lans. 3161

Arb. 3391 TD 3394 5" @ 3391 DD 3399

SSO DD 3402 B/ 2 goph 750 A

DD 3415 FU 1800' oil 16 hr. 750 A

S/ 15 bopd Comp. 30 bopd

J. E. TYRA