


Section 2 Township 18 Range 14W

Well No. #1 Eveleigh

Company Harbar Drlg.

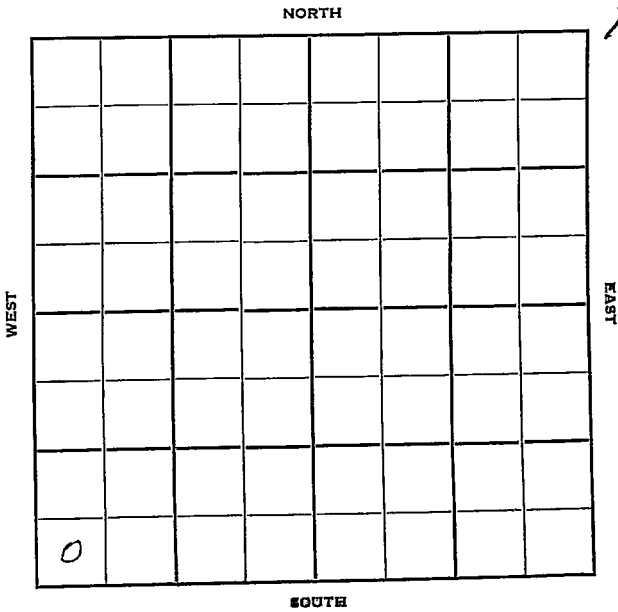

Barton

KANSAS

Sec. 2 Twp. 18 R. 14W

Well No. #1 Eveleigh Farm

Harbar Drlg. Company

Contractor

Boyd Pool


Ft. from N. Line

330' Ft. from S. Line

Ft. from E. Line

330' Ft. from W. Line

SW SW SW

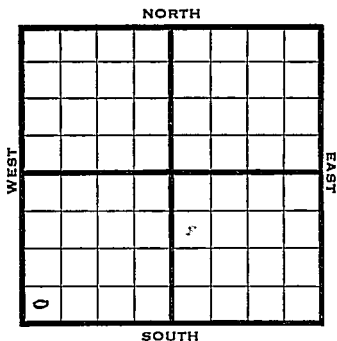

1950

Elev 1893'

REPORT

2/15

RUR

4/19

TD 3378'
 Anhy 840
 82@ 850
 5"@ 3366'
 Heeb 3060'
 Lans 3132'
 Gong 3343'
 Arb. 3366-78'
 Swab 7 boph
 Comp 412 bopd
 omp

COMPLETED

Map No. _____ Sec. 2 Twp. 18 R. 14W

Well No. 1 Eveleigh

_____ Harbar Drlg. _____ Company

_____ Contractor

SW SW STM

_____ Ft. from N. Line

330 Ft. from S. Line

_____ Ft. from E. Line

330 Ft. from W. Line

SECTION PLAT



Barton County

Location _____

Rig up _____

Drilling and Remarks:

R U R

RECORD

Cased _____ in., _____ ft.

Sand _____

Gas _____

Oil _____

Total Depth _____

PRODUCTION

1st 24 hrs. Nat. _____

1st 24 hrs. after shot _____

Gas _____ Cu. Ft.

Dry Hole _____

Abandoned _____

Date

FEB 15 1950

J. E. TYRA Scout

Kansas

Boyd Pool

Map No. _____ Sec. 2 Twp. 18 R. 14W

Well No. 1 Lveleigh

Harbar Drlg. Company

Contractor

SW STH SW

E1.1893

SECTION PLAT

_____ Ft. from N. Line

330 Ft. from S. Line

_____ Ft. from E. Line

330 Ft. from W. Line

COMPLETE			
0			

Barton County

Location _____

Rig up _____

Drilling and Remarks:

anhy 840
8" c 850
5" c 3366
Neck. 3060
Lans. 3132
Cong. 3343
arb. 3366-78

RECORD

Cased _____ in., _____ ft.

Sand _____

Gas _____

Oil _____

Total Depth 3378

PRODUCTION

1st 24 hrs. Nat. _____

1st 24 hrs. after shot _____

Gas _____ Cu. Ft.

Dry Hole _____

Abandoned _____

Swab 7 bopd
 Date *Cong. 412 bopd*

APR 19 1950

19

J. E. TYRA

Scout