


Section 34 Township 20 Range 12-W

Well No. #3 Langler

Company Kewanee Oil

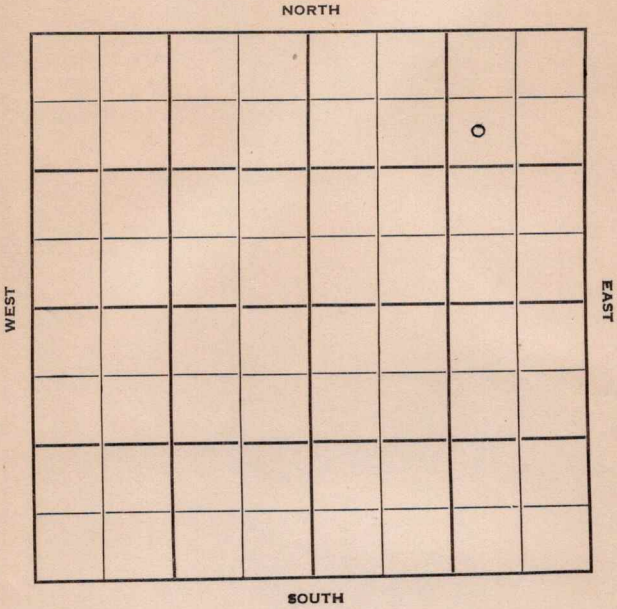

Barton

KANSAS  
12W ✓

Sec. 34 Twp. 20 R. 12W

Well No. #3 Langler Farm

Kewanee Oil Company

Gross Supply Contractor  
Bryant Pool


990' Ft. from N. Line

\_\_\_\_\_ Ft. from S. Line

990' Ft. from E. Line

\_\_\_\_\_ Ft. from W. Line

SW NE NE

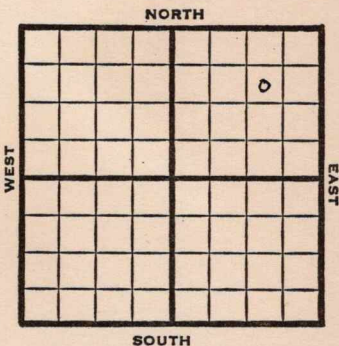

1950	Elev 1836 REPORT
6/28	Spud 6-25-50 8" @ 251'
8/16	8" @ 251 Heeb 3024 KC 3164 Arb 3395-96 TD 3404 5" @ 3394 B/1½ go 3 tw 9 hr 500 A S/3 boph 1000 A FU 1400' fluid S/9.2 bo 2 hr Comp 100 bopd Completed <b>COMPLETED</b>

Map No. \_\_\_\_\_ Sec. 34 Twp. 20 R. 12W

Well No. 3 Langler

Kewanee Oil Company

Gross Supply Contractor

SW NE NE

SECTION PLAT

990 Ft. from N. Line

\_\_\_\_\_ Ft. from S. Line

990 Ft. from E. Line

\_\_\_\_\_ Ft. from W. Line

			o

FIRST REPORT

Barton County

Location \_\_\_\_\_

Rig up \_\_\_\_\_

Drilling and Remarks:

Spud 6-25-50

8" @ 251

RECORD

Cased \_\_\_\_\_ in., \_\_\_\_\_ ft.

Sand \_\_\_\_\_

Gas \_\_\_\_\_

Oil \_\_\_\_\_

Total Depth \_\_\_\_\_

PRODUCTION

1st 24 hrs. Nat. \_\_\_\_\_

1st 24 hrs. after shot \_\_\_\_\_

Gas \_\_\_\_\_ Cu. Ft.

Dry Hole \_\_\_\_\_

Abandoned \_\_\_\_\_

Date

JUN 28 1950 19

J. E. TYRA Scout

County Barton State Kansas

Sec. 34 (Blk. 20) (Sur. 12W) (Twp. 20) (Rge. 12W) Map No. 12W

Operator Kewanee Oil

Well No. 3 Farm Langler

Elev. 1836 Location SW NE NE


**COMPLETE**

990 Ft. From N Line NE

990 Ft. From E Line Quarter

Ist. Report

Completion AUG 16 1950

Remarks

Bryant Pool

Spudding Date 6-25-50

Drlg. Data Oil well TD3404

8" @ 251 Heeb. 3024 KC 3164

Arb. 3395-96 TD 3404 5" @ 3394

B/ 1½ go 3 gw 9 hr. 500 A

S/ 3 boph 1000 A FU 1400' fluid

S/ 9.2 bo 2 hr. Comp. 100 bopd

J. E. TYRA