


Section 16 Township 30 Range 8 E

Well No. # 5 Ferguson

Company A. H. Reneau

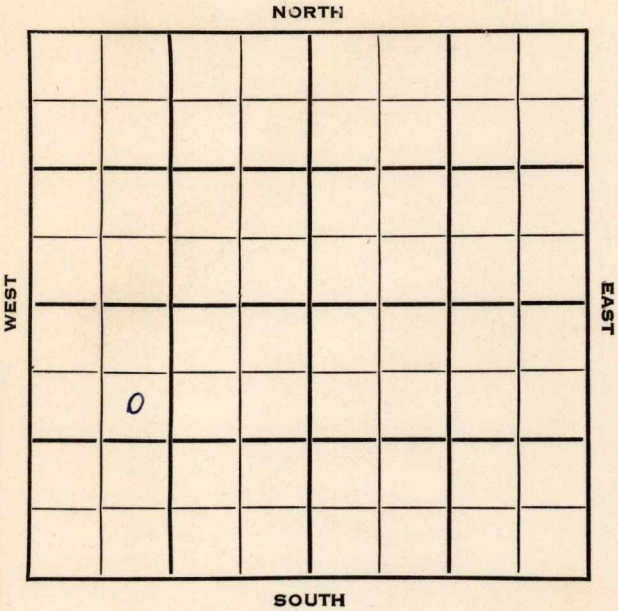

Cowley KANSAS

SEC.	TWP.	R.
16	30	8E ✓

WELL NO. **5 Ferguson** FARM

COMPANY **A. H. Reneau**


CONTRACTOR

990 Ft. from N. Line

Ft. from S. Line

Ft. from E. Line

990 Ft. from W. Line

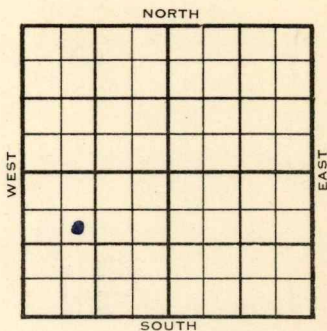

SE NW SW

1954

ELEVATION

1526' RB

REPORT

4/21

D&A

TD 2211'

Lans 1555', Stal. 1590', Layton 2002'

KC 2007'

TD 2211'

D&A

FIRST REPORT

+

ABANDONED

County **Cowley** State **Kansas**
 Sec. **16** (Blk.) **30** (Sur.) **8E** Map No.

Operator **A. H. Reneau**

Well No. **5** Farm **Ferguson**

Elev. **1526 RB** Location **SE NW SW**



990 Ft. From **N** Line **SW**

990 Ft. From **W** Line **Quarter**

1st. Report **APR 21 1954**

Completion **APR 21 1954**

Remarks

Spudding Date

Drlg. Data **D & A** **TD 2211**

Lans. 1555 Stal. 1590 Layton 2002

KC 2007 TD 2211

D & A