

Sedgwick


KANSAS

SECTION 1 TOWNSHIP 26 RANGE ~~##~~## 2E

WELL NO. #1 E.Berschinger

COMPANY Aurora Gasoline & Nate Appleman

NORTH

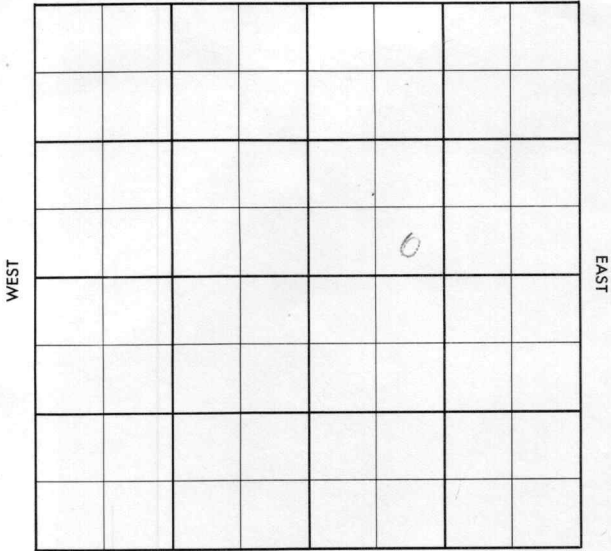

SOUTH

WEST

EAST

Sedgwick KANSAS

SEC. 1	TWP. 26	R. 2E
------------------	-------------------	-----------------

WELL NO. **##1 E. Berschinger** FARM

COMPANY **Aurora Gasoline & Nate Appleman**

CONTRACTOR **Shawmer-Armour**

NE Greenwich

_____ Ft. from N. Line

_____ Ft. from S. Line

_____ Ft. from E. Line

_____ Ft. from W. Line

WEST

EAST

SOUTH

SE SW NE

	ELEVATION	REPORT
1956	1350'	
5-9		Comm. 5-4-56 8" @ 102 w/85 Drlg. 2081
5-16		DST 2809-30 op 30 min. rec. 6' G&OCM, BHP 510/20". DST 2835-46 op 90 min. rec. 60' gas + 60' OCM, BHP 740/30". DST 2839-50 op 90 min. rec. 80' O & wtr. BHP 780/30". D & A Log tops: KC. 2372', M. 2808', M. Chert 2846'. TD 2875'
		ABANDONED

County Sedgwick Elev. _____
 Sec. 1 Twp. 26 Rgs. 2E
 Company Aurora Gasoline & Nate Appleman
 FarmName E. Berschinger No. 1

TOPS	DEPTH	LOG	DATUM
Anh.			
Tp.			
H.			
Tr.			
Dg.			
Bl.			
L.			
K.C.			
B.K.C.			
Ce.			
C.			
M.			
M.			
K.			
Mz.			
Mo.			
V.			
S.			
S.			
A.			
R.			
PE.			
G.			
T.D.			

Loc. in Sec. SE SW NE
 Geol. _____
 Contr. Shawver-Armour
 Pool NE Greenwich

FIRST REPORT
 0
 MAY 9 '56

Date Comm. 5-4-56
8 1/2 @ 102/85 d rlg. 2081

MAY 11 1956

~~29~~

Co.
 No.
 Sec.
 T.
 R.

