


Section 34 Township 20 Range 12W

Well No. #4 Langrehe

Company Keyes Drlg.

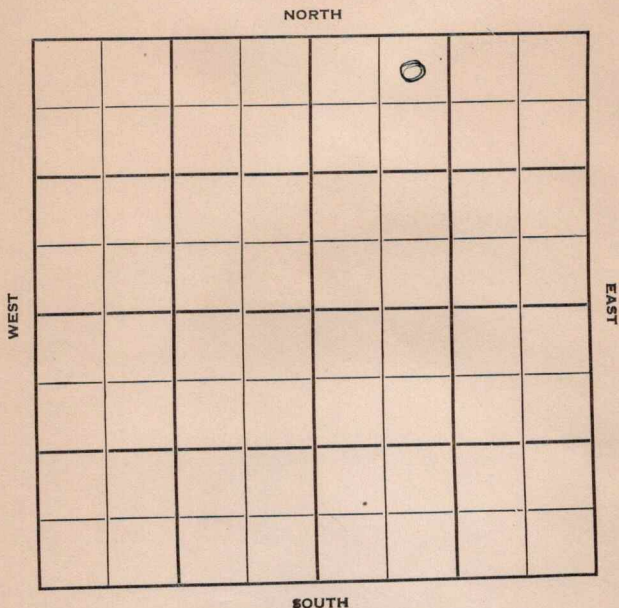

Sec. 34 Twp. 20 R. 12W

Well No. #4 Langreha Farm

Keyes Drlg. Company

Keyes Drlg. Contractor

Workman Pool


330' Ft. from N. Line

 Ft. from S. Line

 Ft. from E. Line

990' Ft. from W. Line

NE NW NE

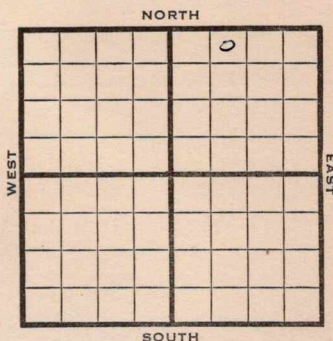

1949

Elev 1838'

REPORT

11/2

8" @ 263'

Anhy 615'

Drlg. 2535'

11/9

Arbuckle 3397'

TD 3401'

5" @ 3397'

11/16

"

11/23

TD 3409'

6500 acid

Swb 7½ bbls oil PH 8 hrs.

11/29

"

12/7

"

12/14

"

12/21

"

12/28

"

1950

1/11

TD 3409'

8"@ 263'

5"@ 3397'

Lans 3171'

Arb. 3397'

PP 29 BOPD / 65% wtr.

Comp

COMPLETED

Kansas

Workman Pool

Map No. _____ Sec. 34 Twp. 20 R. 12WWell No. 4 Langrehe

Keyes Drlg. _____ Company

Keyes Drlg. _____ Contractor

NE NW NE

FIRST REPORT

330 Ft. from N. Line

_____ Ft. from S. Line

_____ Ft. from E. Line

990 Ft. from W. Line

		0	

Barton County

Location _____

Rig up _____

Drilling and Remarks:

8" @ 263

Anhy 615

drlg. 2535

RECORD

Cased _____ in., _____ ft.

Sand _____

Gas _____

Oil _____

Total Depth _____

PRODUCTION

1st 24 hrs. Nat. _____

1st 24 hrs. after shot _____

Gas _____ Cu. Ft.

Dry Hole _____

Abandoned _____

Date

NOV 2 1949 19

S. J. LEWIS

Scout

Kansas

Workman Pool

Map No. _____ Sec. 34 Twp. 20 R. 12WWell No. 4 Langrehr

Keyes Drlg.

Company _____

Contractor _____

NE NW NE

Elev 1838
SECTION PLAT330


Ft. from N. Line

Ft. from S. Line

Ft. from E. Line

990

Ft. from W. Line

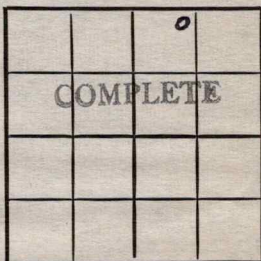

Barton County

Location _____

Rig up _____

Drilling and Remarks:

8" @ 263

5" @ 3397

Lan 3171

Arb. 3397

PP 29 BOPD

+ 65% wtr.

RECORD

Cased _____ in., _____ ft.

Sand _____

Gas _____

Oil _____

Total Depth 3409

PRODUCTION

1st 24 hrs. Nat. _____

1st 24 hrs. after shot _____

Gas _____ Cu. Ft.

Dry Hole _____

Abandoned _____

Date

JAN 11 1950

19

J. E. TYRA

Scout