


Section 34 Township 20 Range 12 W

Well No. #6 Langrehr

Company Kewanee Oil

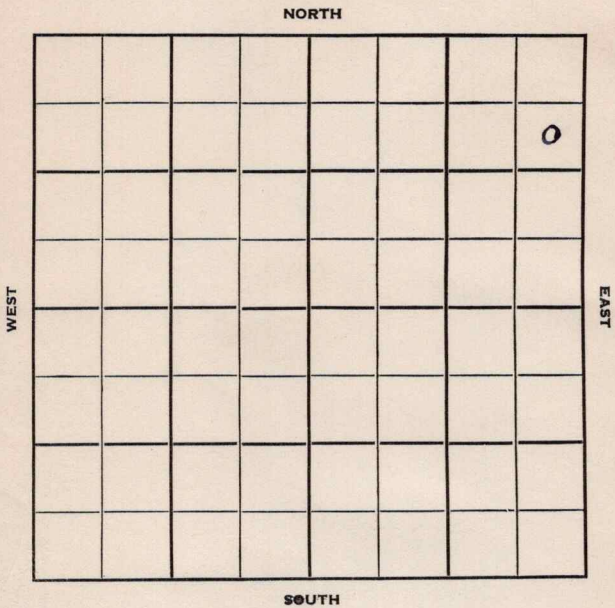

Barton

KANSAS

Sec. 34 Twp. 20 R. 12W

Well No. #6 Langrehr Farm

Kewanee Oil Company

Rhodes Contractor


990 Ft. from N. Line

         Ft. from S. Line

330 Ft. from E. Line

         Ft. from W. Line

SE NENE

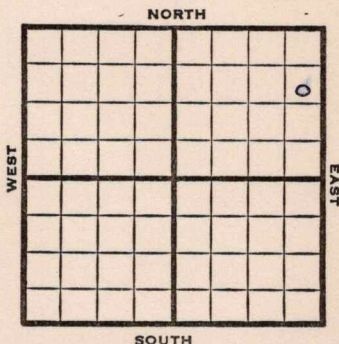

1952

Elev. 1831'

# REPORT

2/20

Location

3/5

Heeb. 3010

Br Li 3137

Lans. 3160

Arb. 3383-3385 RTD

5" @ 3384 WOC

3/11

DD 3402 1/2 B 3 1/2 gal. Oil ph 103

Trying to A

3/19

(Cor TD 3400) 1000 A Test 1 boph

10/ 3392-95 2000 A S/ 16 boph

for 12 hrs & 1% wtr. POP

P/ 77 BO & 177 BW 24 hrs. PB 3399'

Tstg.

3/26

Spud 2-22-52

Oil well TD 3400' 8" @ 253

Heeb 3010' Br. lime 3137'

Lans 3160' Arb. 3383'

TD 3385' 5" @ 3384 DD 3400

B/3 1/2 GOPH 1000 A 1 BOPH

10/3392-95 2000 A S/16 BOPH

12 hr. 1% water

P/77 BO 170 BW 24 hr.

PB 3399'

Comp. 35 BOPD 60% water

COMPLETED

County Barton State KansasSec. 34 (Blk.) 20 (Sur.) 12W Map No.  
(Twp.)Operator Kewanee OilWell No. 6 Farm LangrehrElev. Location SE NE NE

|  |  |  |  |  |  |  |  |  |  |
|--|--|--|--|--|--|--|--|--|--|
|  |  |  |  |  |  |  |  |  |  |
|  |  |  |  |  |  |  |  |  |  |
0

FIRST REPORT

990 Ft. From N Line NE330 Ft. From E Line Quarter1st. Report FEB 20 1952

Completion

Remarks

Rhodes - Contr.

Spudding Date

Drlg. Data

Location

J. G. McGEHEE

County Barton State Kansas  
 Sec. 34 (Blk.) 20 (Sur.) 12W Map No.   
 Operator Kewanee Oil  
 Well No. 6 Farm Langrehr  
 Elev. 1831 Location SE NE NE

|  |  |  |  |  |  |  |  |
|--|--|--|--|--|--|--|--|
|  |  |  |  |  |  |  |  |
|  |  |  |  |  |  |  |  |
COMPLETE

990 Ft. From N Line NE330 Ft. From E Line Quarter

1st. Report

Completion MAR 26 1952

Remarks

Rhodes - Contr.Spudding Date 2-22-52Drig. Data Oil well TD 34008" @ 253 Heeb. 3010 Br. lime 3137Lans. 3160 Arb. 3383 TD 3385 5" @ 3384DD 3400 B/  $3\frac{1}{2}$  goph 1000 A 1 boph10/ 3392-95 2000 A S/ 16 boph 12 hr.1% water P/ 77 bo 170 bw 24 hr.PB 3399 Comp. 35 bopd 60% water

J. G. McGEHEE