

KANSAS

Form 51—5M—7-39—Palace

Cowley



Section 6 Township 30 Range 8-E

Well No. #1 Mahannah

Moore Oil

Company

NORTH Wild cat

WEST

EAST

SOUTH

KANSAS

Cowley

Sec. 6 Twp. 30 R. 8-EWell No. #1 Mahannah FarmMoore Oil Company


(Wildcat)

_____ Ft. from N. Line

_____ Ft. from S. Line

_____ Ft. from E. Line

_____ Ft. from W. Line

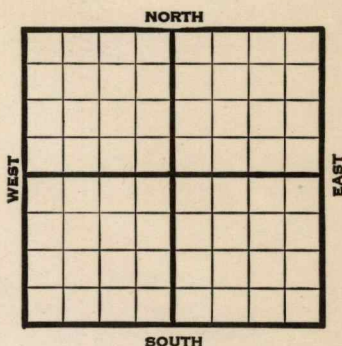

C S L Lot 19

	REPORT
1939	
11/15	(Cannot get any feet measurements. A big Section)
	Drlg. 900'
11/23	4 M gas 1125-30'
	12" - 1180' Drlg. 1210'
11/29	10" - 1305' T.D. 1625' U.R.
	10".
12/7	K.C. 1930' Drlg. 2185'
12/14	Shut down.
12/21	8" - 2125' Miss. 2708'
	6" - 2960' B. Miss. 3078'
	T.D. 3091' Run 5".
12/28	" " "
1940	
1/4	" " "
1/10	Wilcox 3094'
	Arb. 3099'
	HFW 3122-24'
	T.D. 3200'
	ABANDONED

Cowl ey

KANSAS

Map No. 10 Sec. 6 Twp. 30 R. 8EWell No. 1 MahannahMoore Oil

Company

Contractor

FIRST REPORT

SECTION PLAT

C S L Lot 19

_____ Ft. from N. Line

_____ Ft. from S. Line

_____ Ft. from E. Line

_____ Ft. from W. Line

WILDCAT

Location _____

Rig up _____

Drilling and Remarks:

Drlg. 900

Cannot get any
foot measurements.

A big section

RECORD

Cased _____ in., _____ ft.

Sand _____

Gas _____

Oil _____

Total Depth _____

PRODUCTION

1st 24 hrs. Nat. _____

1st 24 hrs. after shot _____

Gas _____ Cu. Ft.

Dry Hole _____

Abandoned _____

Date

NOV 15 1939 19

S. J. LEWIS Scout

Cowley

KANSAS

Map No. 10 Sec. 6 Twp. 30 R. 8EWell No. 1 Mahamah

Moore Oil

Company

Contractor

ABANDONED
C S L Lot 19

SECTION PLAT

_____ Ft. from N. Line

_____ Ft. from S. Line

_____ Ft. from E. Line

_____ Ft. from W. Line

WILDCAT

Location _____

Rig up _____

Drilling and Remarks:

*Wildcat 3094**Cor 3099**WFW 3122-24*

RECORD

Cased _____ in., _____ ft.

Sand _____

Gas _____

Oil _____

Total Depth 3200

PRODUCTION

1st 24 hrs. Nat. _____

1st 24 hrs. after shot _____

Gas _____ Cu. Ft.

Dry Hole _____

Abandoned _____

Date

JAN 10 1940

19

S. J. LEWIS

Scout