


KANSAS

Barton

Section 34 Township 20 Range 12-W

Well No. #6 Lanterman

Company E Adair
workman Pool

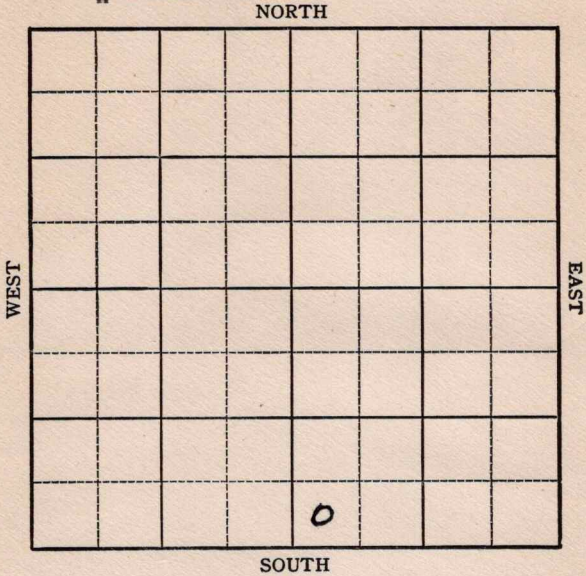

KANSAS

Barton ✓

Sec. 34 Twp. 20 R. 12W

Well No. 6 Lanterman Farm

E. Adair

Company

Workman Pool


 Ft. from N. Line

330 Ft. from S. Line

 Ft. from E. Line

330 Ft. from W. Line

SW SE

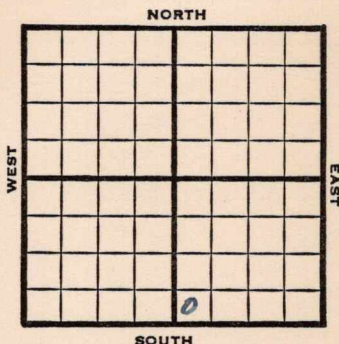

1949	Elev 1839'	REPORT
8/24	RUR	
8/31	8" @ 256'	
9/7	Drlg. 2300'	
9/14	"	
9/21	Arb. 3404'	
9/28	5" @ 3405'	
10/5	TD 3430'	
10/12	200 Oil	
10/19	"	
10/26	1000 acid	
11/2	"	
	TD 3430'	
	Arb. 3404'	
	5" @ 3405'	
	1000 acid	
	Pump 40 Oil Pot	
	40° Gr.	
	Comp	
	COMPLETED	

Map No. _____ Sec. 34 Twp. 20 R. 12W

Well No. 6 Lanterman

E. Adair Company

Contractor

SW SE

FIRST REPORT
SECTION PLAT

_____ Ft. from N. Line

330 Ft. from S. Line

_____ Ft. from E. Line

330 Ft. from W. Line

Barton County

Location _____

Rig up _____

Drilling and Remarks:

R U R

RECORD

Cased _____ in., _____ ft.

Sand _____

Gas _____

Oil _____

Total Depth _____

PRODUCTION

1st 24 hrs. Nat. _____

1st 24 hrs. after shot _____

Gas _____ Cu. Ft.

Dry Hole _____

Abandoned _____

Date


AUG 24 1949 19 S. J. LEWIS Scout

Kansas

Workman Pool

Map No. _____ Sec. 34 Twp. 20 R. 12WWell No. 6 LantermanE. Adair CompanyCOMPLETE Contractor

SW SE

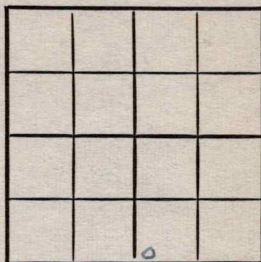E. 1. 1839
SECTION PLAT

_____ Ft. from N. Line

330 Ft. from S. Line

_____ Ft. from E. Line

330 Ft. from W. LineBarton County

Location _____

Rig up _____

Drilling and Remarks:

Cr 34045' 034051000 acidRun 40 oil Pt.40 2/3

RECORD

Cased _____ in., _____ ft.

Sand _____

Gas _____

Oil _____

Total Depth 3400

PRODUCTION

1st 24 hrs. Nat. _____

1st 24 hrs. after shot _____

Gas _____ Cu. Ft.

Dry Hole _____

Abandoned _____

Date

NOV 2 1949 19S. J. LEWIS

Scout