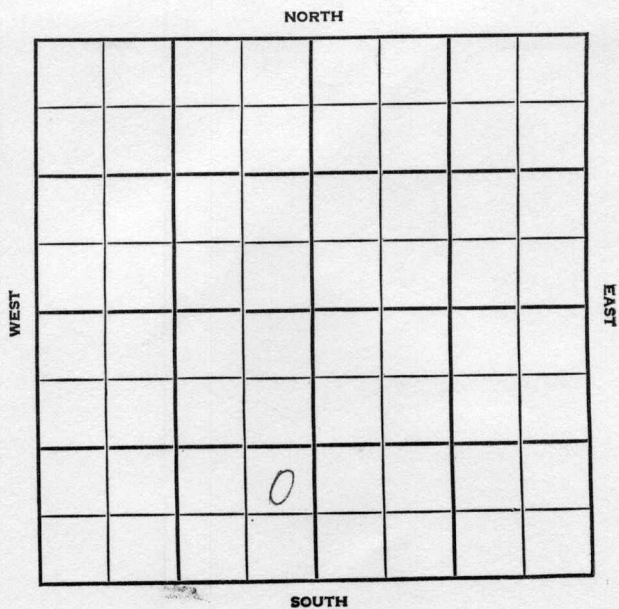


Section 1 Township 26 Range 2EWell No. #1 ElliottCompany Aurora Gasoline

County Sedgwick Elev. _____
Sec. 1 Twp. 26 Rge. 2E
Company Aurora Gasoline
Farm Name Elliott No. 1

TOPS	DEPTH	LOG	DATUM
Anh.			
TP.			
H.			
Tr.			
Dg.			
Bl.			
L.			
K.C.			
B.K.C.			
Ce.			
C.			
M.			
M.			
K.			
Mz.			
Me.			
V.			
S.			
S.			
A.			
R.			
PE.			
G.			
T.D.			

Loc. in Sec. NE SE SW
Geol. _____
Contr. Bedell & Catt
Tools
Pool Greenwich

Nov 28 '56
FIRST REPORT
0

Date Comm. _____
Location
29

Co.
Lse.
No.
Sec.
T.
R.

County Sedgwick Elev. 1336 Co. 1
 Sec. 1 Twp. 26 Rge. 2E
 Company Aurora Gasoline
 Farm Name ELLIOTT No. 1

TOPS	DEPTH	LOG	DATUM	Loc. in Sec.
Anh.				NE SE SW
Tr.				
Dg.				
BL.				
L.				
K.C.	2350	2350		Geol.
B.K.C.	2500	2513		Contr.
Ce.		2780		Bedell & Catt
C.		2795		Tools
M.	2816	2828		Pool
M. <u>Chert</u>		3098		Greenwich
K.				
Mz.				
Ma.				
V.	3140	3150		
S.				
S.				
A.				
R.				
Pe.				
G.				
TD.	3152	3162		

COMPLETE
 JAN 30 '57
 0

Date Comm.

Location DEC 5 '56 ✓ DEC 12 '56 12-4-56
8 7/8 105 DST 2466-85 1hr. DEC 19 '56
no rec. BHP 1005
DST 2800-21 1hr. G/12" rec
1581' oil + 124' MCO + 248'
08' GCSW + 124' SW BHP 785
2970 DEC 26 '56 DST 3140-52 1hr
1005' sulpwte BHP 1160/20"
5 1/2 2942/125 JAN 2 '57 CO 2/

2835-36 10/2839-42 SQ

CO 2834 12/2828-31

no test 1/4 \$ 53 BFPH 50%

Wt Pop JAN 10 '57 JAN 23 '57 JAN 30 '57

P. 95 Bopd + 95 Bwpd.