


Okk

Form 51-5M-11-31-Palace

Map No. **KANSAS** Sec. 13 Twp. 30 R. 8E

Well No. 1-Burge Farm
Hunt & Croft Company

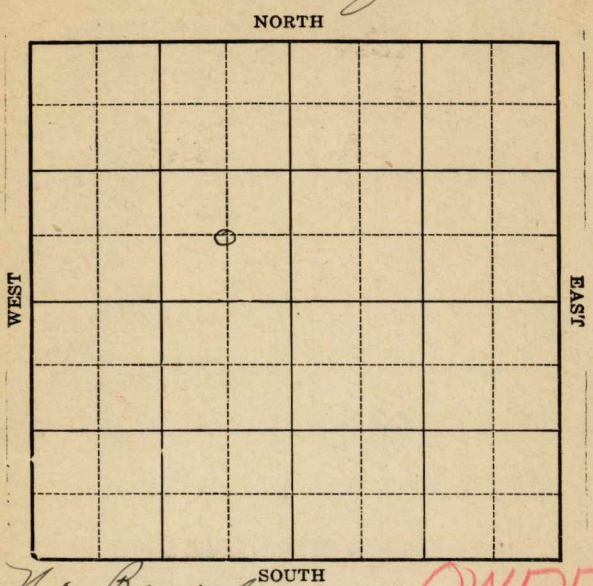

No Record

OWDD

Location _____
Drilling Remarks _____

Rig Up _____
Drilling Remarks _____

RECORD

Cased _____ in. _____ ft.
Sand _____
Gas _____
Oil _____
Total Depth _____

PRODUCTION

1st 24 hrs. Nat. _____
1st 24 hrs. after shot _____
Gas _____ cu. ft.
Dry Hole _____
Abandoned _____

Map No. **KANSAS** Sec. 13 Twp. 30 R. 8^E
 Well No. 1- Burge Farm
Hunt & Croft Company


Ft. from N. Line

660 Ft. from S. Line

660 Ft. from E. Line

Ft. from W. Line

1932

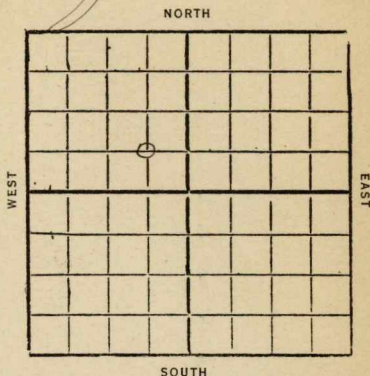

Date	REPORT
	OWDD No record
8/24	Ord TD 1652 Ang 6" & Clg out
8/31	
9/7	TD 1780 Fishing 6"
9/14	
9/21	SD 1925
9/30	
10/5	
10/12	Drig 2015'
10/19	SD 2015
10/26	TD 2015' fsg tools
11/2	Drig 2112
11/9	" 2205'
11/16	TD 2205' fishing
11/23	SD 2250'
11/30	11/11 — 3/4 —
12/7	11/18 — 3/8 —
12/14	1/25 — 3/10 —
12/21	2/1 — 3/22 —
12/28	2/8 — 3/29 —
1933	2/15 — 4/4 —
174	2/22 — 4/2 —

1933
4/9 S.W. at 2250'
4/26 —
5/4 —
5/10 —
5/17 —
5/24 —
6/1 —
6/18 5" 2263 dily 2265
6/15 2320 SD
6/21 2390 U.R. 5"
6/27 2550 U.R. 5"
7/5 —
7/12 —
7/19 — 2568'
7/26 dily 2535
8/2 Top Mier 2585 - N.T.W 2560'
8/9 U.R. 5" 2666'
8/17 —
8/23 —
8/30 dily 2790'
9/6 " 2900'
9/13 - D. + Q. 2903

ABANDONED

10 **KANSAS** *6th*
 Map No. _____ Sec. *13* Twp. *30* R. *8* ^E

Well No. *1* *Burge*
Hunt & Craft Company
 Contractor

FIRST REPORTS

_____ Ft. from N. Line

660 _____ Ft. from S. Line*660* _____ Ft. from E. Line

_____ Ft. from W. Line

SECTION PLAT

	<i>"OWO"</i>		
	<i>o</i>		

No record

Location _____

Rig up _____

Drilling and Remarks:

Old T.D. 1652
now 6" & C.O.

RECORD

Cased _____ in., _____ ft.

Sand _____

Gas _____

Oil _____

Total Depth _____

PRODUCTION

1st 24 hrs. Nat. _____

1st 24 hrs. after shot _____

Gas _____ Cu. Ft.

Dry Hole _____

Abandoned _____

No Record

Date

AUG 24 1932 **CHAS. L. SHERWOOD**
 _____ 192 _____ Scout

Map No. 10 Sec. 13 Twp. 30 R. 8 E

Well No. 1- Burge

Hunt + Craft Company

Contractor

SECTION PLAT

Ft. from N. Line

660 Ft. from S. Line

660 Ft. from E. Line

Ft. from W. Line

	0		

ABANDONED

Location

Rig up

Drilling and Remarks:

N + H

RECORD

Cased in., ft.

Sand

Gas

Oil

Total Depth 2903

PRODUCTION

1st 24 hrs. Nat.

1st 24 hrs. after shot

Gas Cu. Ft.

Dry Hole

Abandoned

Date

9/13/33 P. Mannschreck 192 Scout