


Section 34 Township 20 Range 12W

Well No. #11 Lanterman

Company Kewanee Oil

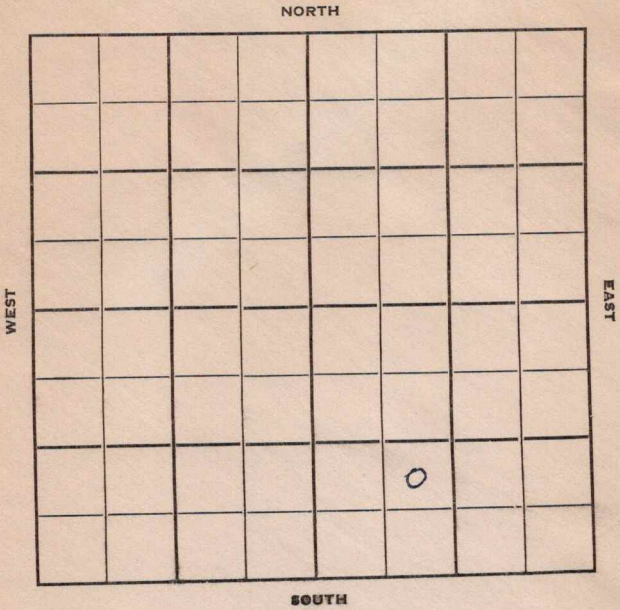

Sec. 34 Twp. 20 R. 12-W

Well No. #11 Lanterman Farm

Kewanee Oil Company

Gross Supply Contractor

Workman


_____ Ft. from N. Line

990 Ft. from S. Line

_____ Ft. from E. Line

990 Ft. from W. Line

NE SW SE

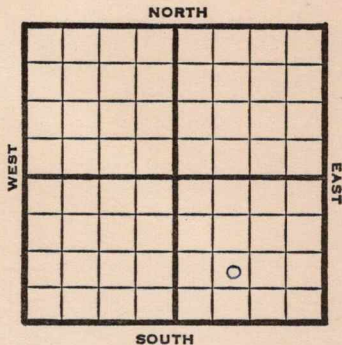

1950

Elev 1847

REPORT

9/13

Location

10/25

Spud 9-20-50

10" @ 271

Anhy 625

Heeb 3017

Br line 3143

Lans 3160

Arb 3391

TD 3403

5" @ 3392

FU 3000' oil 12 hr

Comp 3000 bopd

Completed

COMPLETED

