


Section 16 Township 30 Range 8E

Well No. #7 Ferguson

Company Alva Lenan

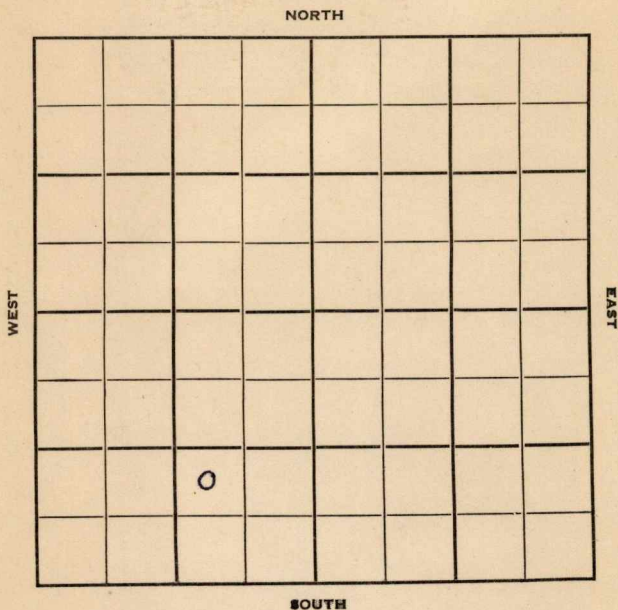

Cowley

KANSAS

Sec. 16 Twp. 30 R. 8E

Well No. #7 Ferguson Farm

Alva Lenan Company

Uhl Drlg. Contractor


Ft. from N. Line

990 Ft. from S. Line

990 Ft. from E. Line

Ft. from W. Line

NW SE SW

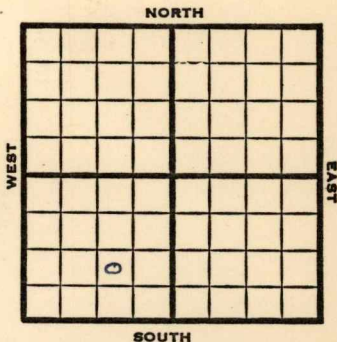

1952

Ele v. -

REPORT

10/15 TD 2215' Run Schl.

11/19 Oil Well

TD 2220'

8" @ 100'

Top. 930, Br. lime 1573, lams
1610, Layton 2012, KC 2020,
stain 2155-60, Pay 2213-20

TD 2220'

5" @ 2209'

Comp. 15 bopd

COMPLETED

County Cowley State Kansas

Sec. 16 (Blk.) 30 (Sur.) 8E Map No.

Operator Alva Lenan

Well No. 7 Farm Ferguson

[illegible]

FIRST REPORT

990 Ft. From S Line SW

990 Ft. From ~~E~~ Line Quarter

1st. Report OCT 15 1952

Completion

Remarks

Uhl Drlg. - Contr.

Spudding Date _____


Drlg. Data

TD 2215 run Schlumberger

County Cowley State Kansas
 Sec. 16 (Blk. 30) (Sur. 8E) Map No.

Operator Alva Lenan
 Well No. 7 Farm Ferguson

Elev. Location NW SE SW

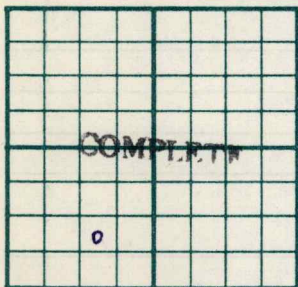

990 Ft. From S Line SW

990 Ft. From E Line Quarter

1st. Report

Completion NOV 19 1952

Remarks

Uhl Drlg. - Contr.

Spudding Date

Drlg. Data Oil well TD 2220

8" @ 100 Top. 930 Br. line 1573

Lans. 1610 Layton 2012 KC 2020

stain 2155-60 Pay 2213-20 TD 2220

5" @ 2209 Comp. 15 bopd

J. G. McGEHEE