


Section 5 Township 26 Range 2-E
Well No. #1 Braers
Company J P Gatty

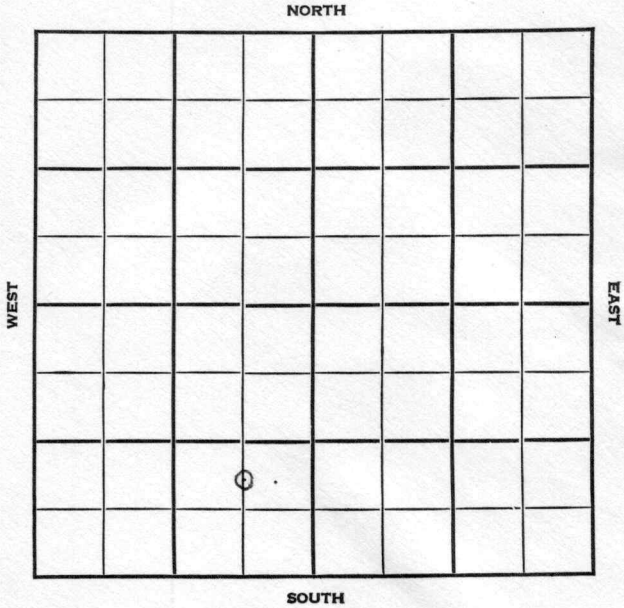

KANSAS

Sedgwick

Sec. 5 Twp. 26 R. 2E ✓Well No. #1 Braers FarmJ. P. Gatty Company

Wildcat


Ft. from N. Line

990' Ft. from S. Line

660' Ft. from E. Line

Ft. from W. Line

C N L SE SW

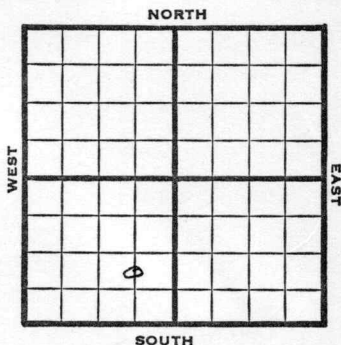1948 Eli 1427' REPORT

7/8 Location
7/14 Mach
7/21 Drlg 720'
7/28 13" @ 900'
Dr;g 1230'

8/4 10" @ 1615'
Drlg. 2000'
8/11 KC 2520'
Drlg 2620'
8/18 Mississippi 2974'
TD 2974'
7" @ 2968'
1000' oil 3/4 hrs.
8/25 Burgess 2971'
7" @ 2968'
TD 2974'
Pump 776' oil Pot
43° Gr.
Comp

COMPLETED

Map No. _____ Sec. 5 Twp. 26 R. 2E

Well No. 1 Braers

J. P. Gatty Company

FIRST REPORT

Contractor

C N L SE SW

SECTION PLAT

_____ Ft. from N. Line

990 Ft. from S. Line

660 Ft. from E. Line

_____ Ft. from W. Line

	0		

Sedgwick County

Location X

Rig up _____

Drilling and Remarks:

RECORD

Cased _____ in., _____ ft.

Sand _____

Gas _____

Oil _____

Total Depth _____

PRODUCTION

1st 24 hrs. Nat. _____

1st 24 hrs. after shot _____

Gas _____ Cu. Ft.

Dry Hole _____

Abandoned _____

Date

JUL 8 1948 19

S. J. LEWIS Scout

Sedgwick County Kansas State

Map No. 13 Sec. 5 Twp. 26 R. 2E

Well No. 1 Braers

J. P. Gatty Company

COMPLETE

Contractor

C N L SE SW


E 11427
SECTION PLAT

 Ft. from N. Line

990 Ft. from S. Line

660 Ft. from E. Line

 Ft. from W. Line

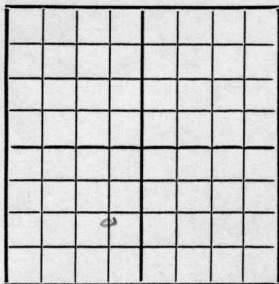

Wildcat

Remarks:

Bugger 2971

7" @ 2968

7" @ 2974

Pony 276 oil Pot

43° SW

Date

AUG 25 1948

Scout

S. J. LEWIS