

KANSAS

Barton

Section 34 Township 20 Range 12WWell No. 1 ZurnischCompany Yarnell

Workman

NORTH

			0				

WEST

EAST

SOUTH

Barton

Sec. 34 **KANSAS** Twp. 20 R. 12W ✓

Well No. #1 Zurnisch Farm _____

Yarnell

Company _____

Workman Pool


990' Ft. from N. Line

_____ Ft. from S. Line

330' Ft. from E. Line

_____ Ft. from W. Line

SE NE NW

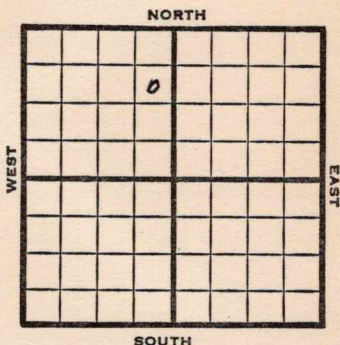

1949

^L
lev 1841

R E P O R T

4/13 RUR

4/20 8" @ 260'
Drlg. 2960'

4/27 TD 3427'

5/4 **Lansing 3182'**
Arbuckle 3428'
TD 3444'
5" @ 3431'

5/10 TD 3448'

5/18 Pump 90 bbls oil 7 hrs.

5/25 "

6/1 "

6/8 **Arb. 3422'**
5" @ 3425'
TD 3452'
Abadd .

ABANDONED

Kansas

Map No. _____ Sec. 34 Twp. 20 R. 12WWell No. 1 ZurnischYarnell

Company

FIRST REPORT

Contractor

SE NE NW


SECTION PLAT

990 Ft. from N. Line

_____ Ft. from S. Line

330 Ft. from E. Line

_____ Ft. from W. Line

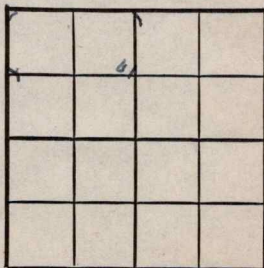

Barton County

Location _____

Rig up _____

Drilling and Remarks:

R U R

RECORD

Cased _____ in., _____ ft.

Sand _____

Gas _____

Oil _____

Total Depth _____

PRODUCTION

1st 24 hrs. Nat. _____

1st 24 hrs. after shot _____

Gas _____ Cu. Ft.

Dry Hole _____

Abandoned _____

Date

APR 13 1949 19S. J. LEWIS

Scout

Barton County Kansas State

Map No. K46 Sec. 34 Twp. 20 R. 12W

Well No. 1 Zurnisch

Yarnell

Company

ABANDONED

Contractor

SE NE NW

E1.1841
SECTION PLAT

990 Ft. from N. Line

_____ Ft. from S. Line

330 Ft. from E. Line

_____ Ft. from W. Line

Workman Pool

Remarks:

Cor 3422

5" C3425

YD3452

Date

JUN 8 1949

Scout S. J. LEWIS