


Section 5 Township 26 Range 2-E

Well No. #1 Brøers

Company White & Ellis

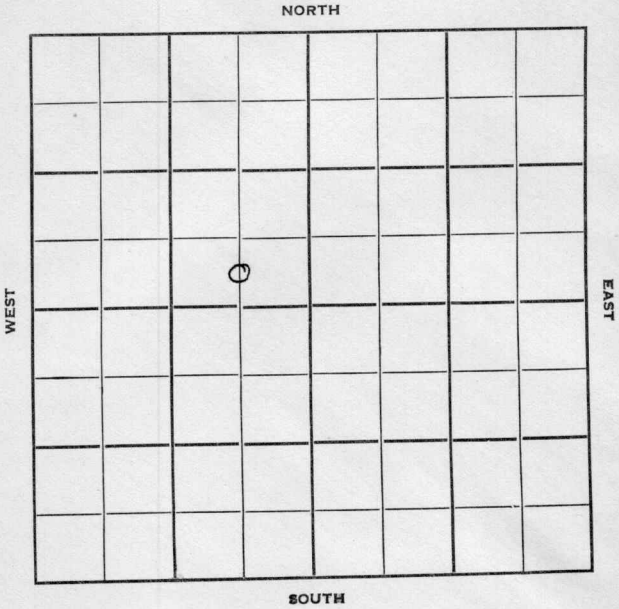

SedgwickKANSAS

Sec. 5 Twp. 26 R. 2E

Well No. #1 Braers Farm

White & Ellis Company

Contractor

Fairview Pool


Ft. from N. Line

330' Ft. from S. Line

560' Ft. from E. Line

Ft. from W. Line

C S L S E N W

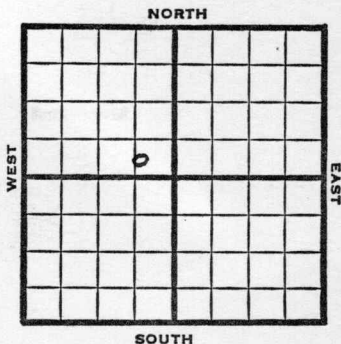

1950

Elev. 1455' REPORT


8/16

Spud 8-8-50
8-5/8" @ 105'
Drlg. 2220'

9/13

Spud 8-8-50
TD 3016'
8-5/8" @ 105'
Miss 2989'
TD 3004'
5" @ 3003'
TD 3016' HFW
D&A

ABANDONED

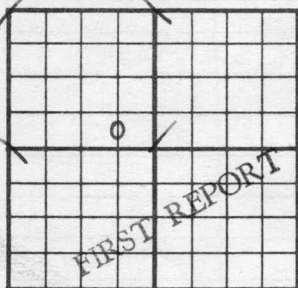
County Sedgwick State KansasSec. 5 (Blk.) 26 (Sur.) 2E Map No.Operator White & EllisWell No. 1 Farm BraersElev. Location C S L SE NW330 Ft. From S Line NW560 Ft. From E Line Quarter1st. Report AUG 16 1950

Completion

Remarks

Spudding Date 8-8-50Drlg. Data Fairview Pool8 5/8" @ 105 drlg. 2220

J. E. TYRA

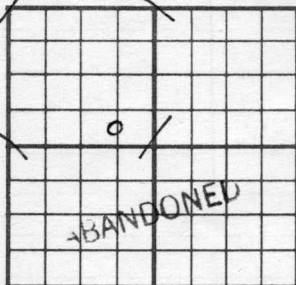County Sedgwick State KansasSec. 5 (Blk.
Twp.) 26 (Sur.
Rge.) 2E Map No.Operator White & EllisWell No. 1 Farm BraersElev. 1455 Location C S L SE NW330 Ft. From S Line NW560 Ft. From E Line Quarter

1st. Report

Completion SEP 13 1950

Remarks

Fairview PoolSpudding Date 8-8-50Drilg. Data D & A TD 30168 5/8" @ 105 Miss. 2989 TD 30045" @ 3003 TD 3016 HFW D & A

J. E. TYRA