


Map No. **KANSAS** Sec. *16* Twp. *26* R. *2E*
Well No. *2 - Swanson* Farm
Patton et al Company

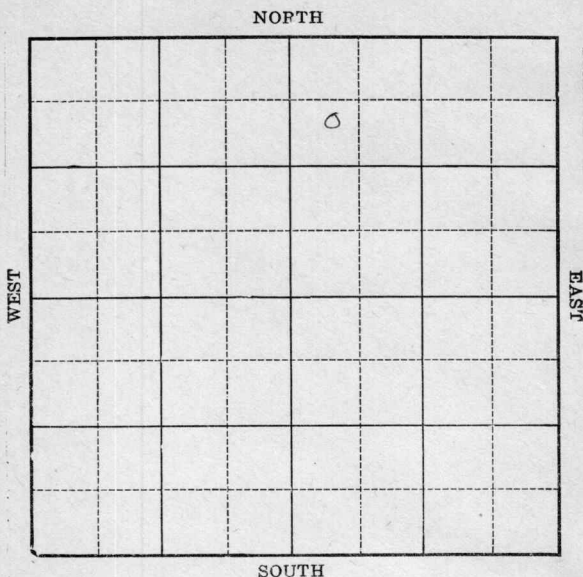

Location _____

Drilling Remarks _____

Rig Up _____

Drilling Remarks _____

RECORD

Cased _____ in. _____ ft.

Sand _____

Gas _____

Oil _____

Total Depth _____

PRODUCTION

1st 24 hrs. Nat. _____

1st 24 hrs. after shot _____

Gas _____ cu. ft.

Dry Hole _____

Abandoned _____

Map No. KANSAS Sec. 6 Twp. 26 R. 2^E

Well No. 2- Swanson Farm

Patton et al Company


830 Ft. from N. Line

_____ Ft. from S. Line

_____ Ft. from E. Line

430 Ft. from W. Line

1932

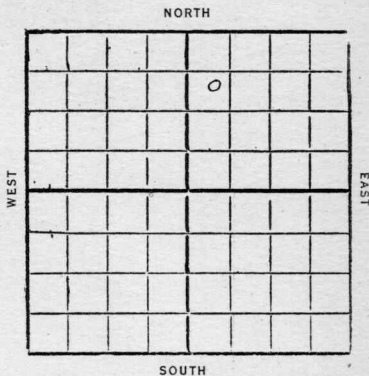

Date

REPORT

4/27	Log 100'
5/4	Drilg 975
5/11	10" 1277 Cly out
5/18	UIR 8"- 1740
5/25	8"- 1733
	Drilg 1785
6/1	" 1945
6/8	" 2085
6/15	" 2510'
6/22	" 2940'
6/29	5" 2961
	and 2988-90
	Pump 245 bbl 24 hr
	shaw B.S.
7/6	TD 2990' No test
7/13	and 2988-90
	TD 2990
	Pump 250 bbl oil
	and 15 bbl water
	39 ⁵ gravity
	Comp.

Sedgwick

E

13 KANSAS

Map No. _____ Sec. *6* Twp. *76* R. *2*Well No. *2* *Swanson**Patton et al* Company

Contractor

FIRST REPORTS

SECTION PLAT

830 Ft. from N. Line

_____ Ft. from S. Line

_____ Ft. from E. Line

430 Ft. from W. Line

		o	

Location _____

Rig up _____

Drilling and Remarks:

Spdy 100'

RECORD

Cased _____ in., _____ ft.

Sand _____

Gas _____

Oil _____

Total Depth _____

PRODUCTION

1st 24 hrs. Nat. _____

1st 24 hrs. after shot _____

Gas _____ Cu. Ft.

Dry Hole _____

Abandoned _____

Date

APR 27 1932

192

CHAS. L. SHERWOOD

Scout

Seaghters

13 KANSAS

Map No. Sec. 6 Twp. 26 R. 2 E

Well No. 2 Swanson

Peterson Oil Co. Company

Contractor

COMPLETED

SECTION PLAT

830 Ft. from N. Line

Ft. from S. Line

Ft. from E. Line

430 Ft. from W. Line

		0	

Location

Rig up

Drilling and Remarks:

Pump 250 Bbs
 Oil & 15 Bbs Water
 39.5 gravity

RECORD

Cased in, ft.

Sand 2988-2990

Gas

Oil

Total Depth 2990

PRODUCTION

1st 24 hrs. Nat.

1st 24 hrs. after shot

Gas Cu. Ft.

Dry Hole

Abandoned

Date

JUL 13 1932

CHAS. L. SHERWOOD

192

Scout