

Well No. 1 - H. Swanson Farm

Bar-Key Pet \_\_\_\_\_ Company

WEST

EAST

SOUTH

### Rig Up \_\_\_\_\_ Drilling Remarks

Cased \_\_\_\_\_ in. \_\_\_\_\_ ft.  
Sand \_\_\_\_\_  
Gas \_\_\_\_\_  
Oil \_\_\_\_\_  
Total Depth \_\_\_\_\_

PRODUCTION

1st 24 hrs. Nat. \_\_\_\_\_

1st 24 hrs. after shot \_\_\_\_\_

Gas \_\_\_\_\_ cu. ft.

Dry Hole \_\_\_\_\_

Abandoned \_\_\_\_\_

*Sedgewick*

Map No. KANSAS Sec. 6 Twp 26 R. 26

Well No. 1 - H Swanson Farm


Bar-Key Pet Company

1320' Ft. from N. Line

         Ft. from S. Line

1320' Ft. from E. Line

         Ft. from W. Line

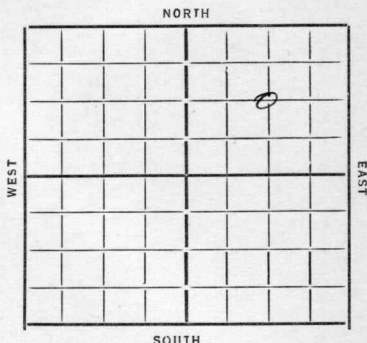

Date 1933

REPORT

|       |                               |
|-------|-------------------------------|
| 11/15 | Rig                           |
| 11/22 | —                             |
| 11/29 | Wreg 780                      |
| 12/6  | T.D. 800 S.D. 12/13 — 12/27 — |
| 1/11  | — 1/17 — 1/24 — 1/31 —        |
| 2/7   | — 2/17 — 2/23 — 3/1 —         |
| 3/8   | — 3/15 — 3/22 — 3/29 —        |
| 4/5   | Dlg 1015 12" 995              |
| 4/12  | " 1620                        |
| 4/19  | " 2000                        |
| 4/26  | " 2025 10" 1717               |
| 5/3   | " 2365                        |
| 5/10  | SD 2905                       |
| 5/18  | 6" 2912                       |
| 5/25  | —                             |
| 5/31  | SD 2912                       |
| 6/7   | — 6/14 —                      |
| 6/21  | dlg 2978 S.O.                 |
| 6/28  | e.o.                          |
| 7/5   | — 7/12 —                      |
| 7/19  | Chit 2980 T.D. 2982 1/2       |
|       | 1000' oil                     |

7/26 Chst 2980 TD 2982 1/2  
1000' oil

8/2 55 Bbls 3 hrs.

8/8 Chst 2980 TD 2982 1/2  
478 Bbls oil  
some water

COMPLETED

Map No. 13 Sec. 6 Twp. 26 R. 2EWell No. 1- H. SwansonBar-Key pit Company

Contractor

## SECTION PLAT


1320 Ft. from N. Line

Ft. from S. Line

1320 Ft. from E. Line

FIRST REPORTS

Ft. from W. Line

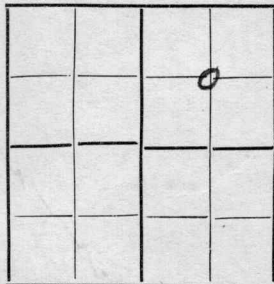

Location

Rig up

Drilling and Remarks:

Rig

## RECORD

Cased.....in., .....ft.

Sand.....

Gas.....

Oil.....

Total Depth.....

## PRODUCTION

1st 24 hrs. Nat.....

1st 24 hrs. after shot.....

Gas.....Cu. Ft.

Dry Hole.....

Abandoned.....

Date

11-15-33 192 O. Mannschuh Scout

KANSAS

Map No. 13 Sec. 6 Twp. 26 R. 2EWell No. 1-H. SwensonBar-Key pit Company

Contractor

COMPLETED

## SECTION PLAT

|  |  |  |  |
|--|--|--|--|
|  |  |  |  |
|  |  |  |  |
|  |  |  |  |
|  |  |  |  |
|  |  |  |  |

1320 Ft. from N. Line

\_\_\_\_\_ Ft. from S. Line

1320 Ft. from E. Line

\_\_\_\_\_ Ft. from W. Line

Location \_\_\_\_\_

Rig up \_\_\_\_\_

Drilling and Remarks:

478 bbl oilsome water

## RECORD

Cased \_\_\_\_\_ in., \_\_\_\_\_ ft.

Sand Chat 2980

Gas \_\_\_\_\_

Oil \_\_\_\_\_

Total Depth 2982 1/2

## PRODUCTION

1st 24 hrs. Nat. \_\_\_\_\_

1st 24 hrs. after shot \_\_\_\_\_

Gas \_\_\_\_\_ Cu. Ft.

Dry Hole \_\_\_\_\_

Abandoned \_\_\_\_\_

Date

8-8-34

19

ORVAL MANNSCHRECK

Scout