


Section 35 Township 20 Range 12 W

Well No. # 6 Batchman

Company B & B Drlg.

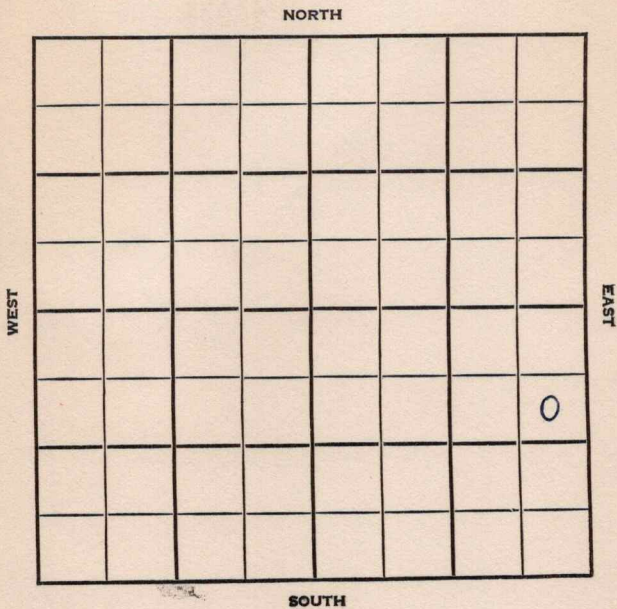

Barton KANSAS


SEC.	TWP.	R.
35	20	12W

WELL NO. 6 Batchman FARM

COMPANY B & B Drlg.

CONTRACTOR Co. Tools
Chase-Silica Pool

990 Ft. from N. Line
 _____ Ft. from S. Line
330 Ft. from E. Line
 _____ Ft. from W. Line

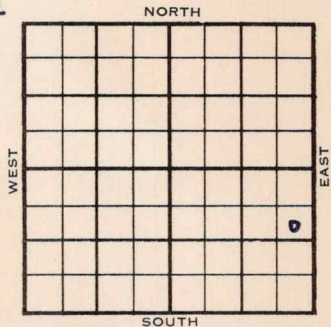

SE NE SE

1954	ELEVATION	REPORT
	1831'	

5/19
6/2

MIR
 Spud 5-19-54 Oil well TD 3403
 8" @ 244 Anhy 601 Heeb 3011
 Br. lime 3142 Lans 3154 Arb. 3393
 TD 3398 5" @ 3397 DD 3403 750 A
 S/2½ BOPH 3 hr.
 Comp. 35 BOPD

COMPLETED

