


Section 5 Township 26 Range 2E

Well No. 1 Korber

Company Shields et al

Misc.
NORTH

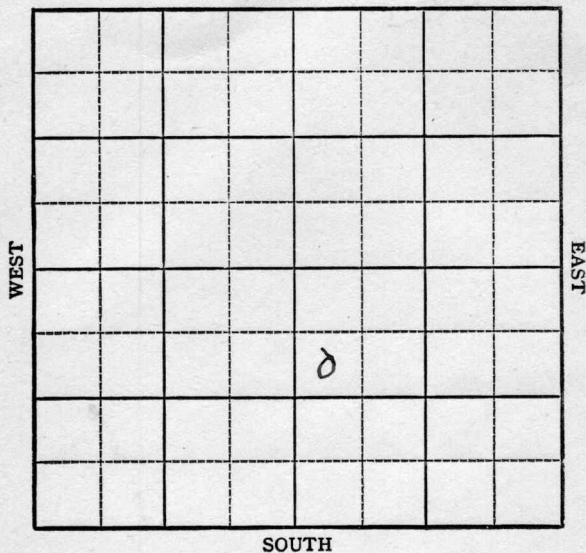

KANSAS

Sedgwick

Sec. 5 Twp. 26 R. 2-E

Well No. #1 Korber Farm

~~Shields~~ et al

Company

Miscellaneous


990 Ft. from N. Line

_____ Ft. from S. Line

_____ Ft. from E. Line

330 Ft. from W. Line

SW NW SE

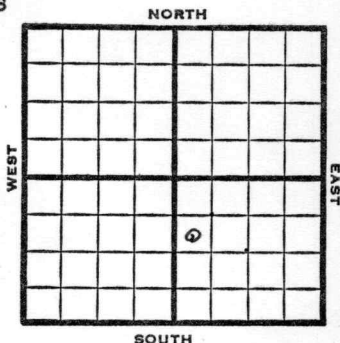

1948

Elev. 1425'

REPORT

9/29

Machine

10/6

15" @ 45'

Drlg. 465'

10/13

Drlg. 1215'

10/19

10" @ 1215'

Drlg. 1950'

10/26

"

11/3

KC 2527'

Drlg 2780'

11/10

"

11/17

Burgess 2929'

TD 2992'

ABANDONED

Map No. _____ Sec. 5 Twp. 26 R. 2E


Well No. 1 Korber

Shields etal. Company

FIRST REPORT Contractor

SW NW SE

SECTION PLAT

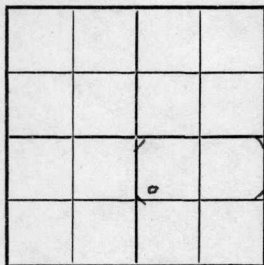

990 Ft. from N. Line

_____ Ft. from S. Line

_____ Ft. from E. Line

330 Ft. from W. Line

Sedgwick County

Location _____

Rig up _____

Drilling and Remarks:

Machine

RECORD

Cased _____ in., _____ ft.

Sand _____

Gas _____

Oil _____

Total Depth _____

PRODUCTION

1st 24 hrs. Nat. _____

1st 24 hrs. after shot _____

Gas _____ Cu. Ft.

Dry Hole _____

Abandoned _____

Date

SEP 29 1948 19 S. J. LEWIS Scout

Map No. 13 Sec. 5 Twp. 26 R. 2E

Well No. 1 Korber

Shields et al. Company

ABANDONED Contractor

SW NW SE


E 61425
SECTION PLAT

990 Ft. from N. Line

 Ft. from S. Line

 Ft. from E. Line

330 Ft. from W. Line

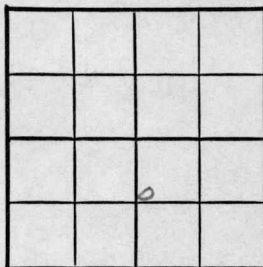

Sedgwick County

Location

Rig up

Drilling and Remarks:

Burgess 2928

RECORD

Cased in., ft.

Sand

Gas

Oil

Total Depth 2992

PRODUCTION

1st 24 hrs. Nat.

1st 24 hrs. after shot

Gas Cu. Ft.

Dry Hole

Abandoned

Date

NOV 17 1948 19

S. J. LEWIS Scout