


Map No. KANSAS Sec. 6 Twp. 26 R. 2^E

Well No. 1 - Swanson Farm
Patton & Kenty Company

330 Ft. from N. Line
____ Ft. from S. Line
____ Ft. from E. Line
330 Ft. from W. Line

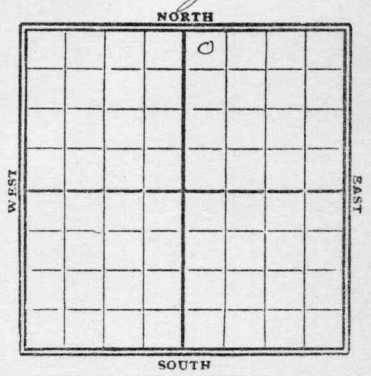

1929

Date	REPORT
2/13	Location
2/20	Bldg Rig
2/27	Rig
3/6	Rig up.
3/13	drlg 450'
3/20	" 1020'
3/27	" 1227'
4/13	fsg tools 1440' - T.D.
4/10	wrlg 1760'
4/17	U 1" 2320'
4/24	U 1 1/2" 8" - 2555' T.D.
5/1	2op chat 3005' - 3010' filled up 2900'
	in 4 hrs - 39 gravity (Black oil) will seob
5/2	2op chat 3005 T.D. 3010 hole fully oil
	Bldg Storage
5/3	hole full oil - 35' cavings to clean out and
	test tomorrow
	(over)

5/6 - swab 984 bbls 21 hrs

5/8 - pump 16 bbls per hr
10% water

5/15 - pump 197 bbls oil
168 bbls water

5/22 - pump 184 bbls oil
" 400 " water

5/29 —

6/5 —

6/12 - sdy line 3005-10'

T.D. 3010'

swab 184 bbl oil
210 bbl water
Pump.

MAP NO. KANSAS SEC. 6 TWP. 26 R. 25

WELL NO. 412 1 Swanson

Patton & Wentz COMPANY

CONTRACTOR

SECTION PLAT

		0	

330 FT. FROM N. LINE

FT. FROM S. LINE

FT. FROM E. LINE

330 FT. FROM W. LINE

FIRST REPORTS

LOCATION ✓

RIG UP

DRILLING AND REMARKS:

RECORD

CASED _____ IN., _____ FT.

SAND _____

GAS _____

OIL _____

TOTAL DEPTH _____

PRODUCTION

1ST 24 HRS. NAT. _____

1ST 24 HRS. AFTER SHOT _____

GAS _____ CU. FT.

DRY HOLE _____

ABANDONED _____

DATE

FEB 13 1929

192

S. J. LEWIS

SCOUT

Map No. KANSAS Sec. 6 Twp. 26 R. 25

Well No. 1 Swanson

Patton & Wentz Company

Contractor

SECTION PLAT

330 Ft. from N. Line

..... Ft. from S. Line

..... Ft. from E. Line

820 Ft. from W. Line

		0	

COMPLETED

Location.....

Rig up.....

Drilling and Remarks:

*Sandy lime
3005-10*

*Swan 184 ft hole
210 ft water*

RECORD

Cased..... in., ft.

Sand.....

Gas.....

Oil.....

Total Depth 3010

PRODUCTION

1st 24 hrs. Nat.....

1st 24 hrs. after shot.....

Gas..... Cu. Ft.

Dry Hole.....

Abandoned.....

Date

JUN 12 1929

192.....

S. J. LEWIS Scout