

KANSAS

Sedgwick

Section 6 Township 26 Range 2E

Well No. 1 Timmerkamp

Company Chas Carlock

Misc
NORTH

WEST

						0	

EAST

SOUTH

KANSAS

Sedgwick

Sec. 6 Twp. 26 R. 2E ✓

Well No. #1 Timmerkamp Farm

Chas. Carlock Company


Miscellaneous (Echman., Cont.)

 Ft. from N. Line

990' Ft. from S. Line

990' Ft. from E. Line

 Ft. from W. Line

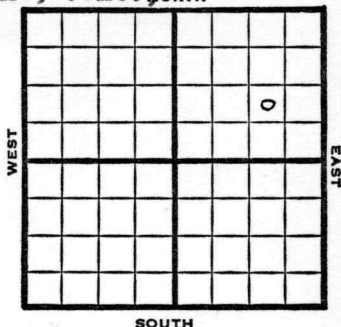

NW SE NE

SOUTH

1949

Elev 1430'

REPORT

5/11

8" @ 103'

All wells plugged

5/18

Drlg 2400'

5/25

Burgess 2785'

TD 2973'

5" @ 2973'

6/1

TD 3006'

Miss 3003'

Aband.

ABANDONED

Kansas

Map No. _____ Sec. 6 Twp. 26 R. 2EWell No. 1 TimmerkampChas. Carlock CompanyEchman Contractor

NW SE NE

FIRST REPORT
SECTION PLAT Ft. from N. Line990 Ft. from S. Line990 Ft. from E. Line Ft. from W. Line

			o

Sedgwick County

RECORD

Location _____

Cased _____ in., _____ ft.

Rig up _____

Sand _____

Drilling and Remarks:

Gas _____

Oil _____

8" @ 103

Total Depth _____

All wells plugged

PRODUCTION

1st 24 hrs. Nat. _____

1st 24 hrs. after shot _____

Gas _____ Cu. Ft.

Dry Hole _____

Abandoned _____

Date

MAY 11 1949 19

S. J. LEWIS Scout

Map No. 513 Sec. 6 Twp. 26 R. 2E

Well No. 1 Timmerkamp

Chas. Carlock Company

ABANDONED Contractor

NW SE NE

E. 1430
SECTION PLAT

 Ft. from N. Line

990 Ft. from S. Line

990 Ft. from E. Line

 Ft. from W. Line

			0

You put it in Sec. 7

Sedgwick County

Location

Rig up

Drilling and Remarks:

Miss 3003

RECORD

Cased in., ft.

Sand

Gas

Oil

Total Depth 3006

PRODUCTION

1st 24 hrs. Nat.

1st 24 hrs. after shot

Gas Cu. Ft.

Dry Hole

Abandoned

Date

JUN 1 1949 19

S. J. LEWIS Scout