FORM 51 25M 3-49 PETROL

KANSAS


Sedgwick

Section 7 Township 26 Range 2E

Well No. 1 Schramm "C"

Company Carlock et al

Misc.

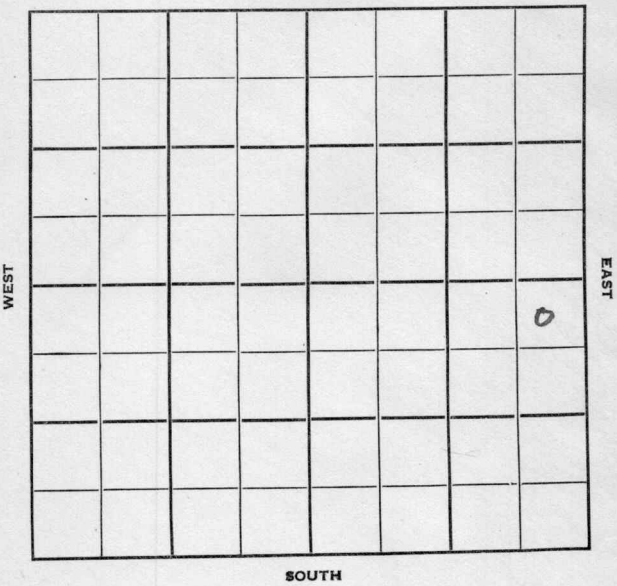

FORM 252-A
5M 10-48 PETROL

Sedgwick KANSAS

Sec. 7 Twp. 26 R. 2E

Well No. #1 Schramm "C" Farm

Carlock et al Company

Miscellaneous (Eckland Drlg, Cont.)


330' Ft. from N. Line

Ft. from S. Line

330' Ft. from E. Line

Ft. from W. Line

NE SE

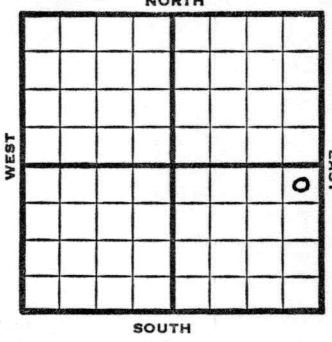

1949	REPORT
	Elev 1414'
8/31	8" @ 96'
9/7	KC 2514' Drlg. 2790'
9/14	Miss 2975' TD 2983' 5"@ 2964'
9/21	TD 2983' Miss 2975' Aband.

ABANDONED

Form 26 200 Bks. 6-49 Petrol

Kansas

Miscellaneous

Map No. _____ Sec. 7 Twp. 26 R. 2E

Well No. 1 Schramm "C"

Carlock etal. Company

Eckland Drlg. Contractor

NE SE

330 Ft. from N. Line


_____ Ft. from S. Line

330 Ft. from E. Line

_____ Ft. from W. Line

Sedgwick County

SECTION PLAT

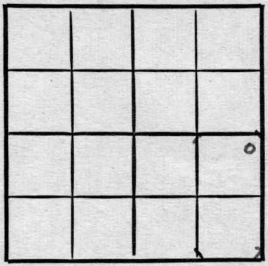

Location _____

Rig up _____

Drilling and Remarks:

8" @ 96

RECORD

Cased _____ in., _____ ft.

Sand _____

Gas _____

Oil _____

Total Depth _____

PRODUCTION

1st 24 hrs. Nat. _____

1st 24 hrs. after shot _____

Gas _____ Cu. Ft.

Dry Hole _____

Abandoned _____

Date

AUG 31 1949 19 S. J. LEWIS Scout

Form 26 200 Bks. 6-49 Petrol

Kansas

Miscellaneous

Map No. K13 Sec. 7 Twp. 26 R. 2E

Well No. 1 Schramm "C"


Carlock etal. Company

ABANDONED Contractor

NE SE

El. 1414

SECTION PLAT

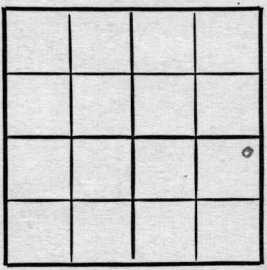

330 Ft. from N. Line

Ft. from S. Line

330 Ft. from E. Line

Ft. from W. Line

Sedgwick County

Location

Rig up

Drilling and Remarks:

Miss 2975-

RECORD

Cased in., ft.

Sand

Gas

Oil

Total Depth 2983

PRODUCTION

1st 24 hrs. Nat.

1st 24 hrs. after shot

Gas Cu. Ft.

Dry Hole

Abandoned

Date

SEP 21 1949 19

S. J. LEWIS Scout