
FORM 51 25M 3-49 PETROL Sedgwick KANSAS

Section 7 Township 26 Range 2E

Well No. #1 Matson

Company Morrison Drlg. et al

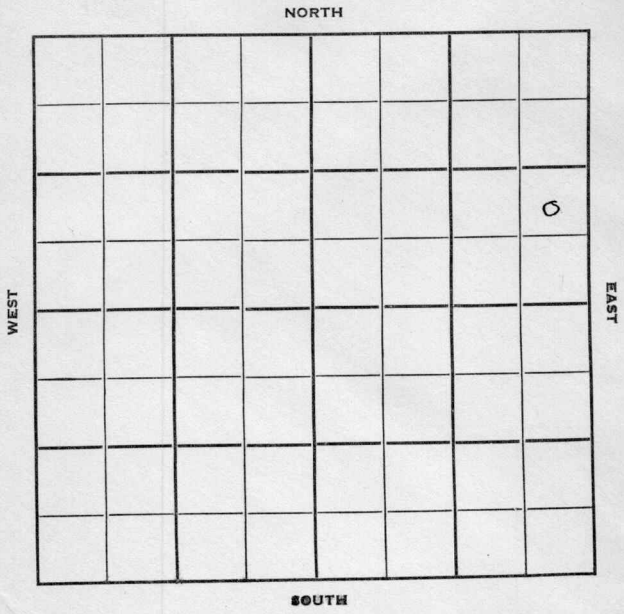

FORM 252-B
10M 11-50 PETROL

Sedgwick

Sec. 7 Twp. 26 R. 2E KANSAS

Well No. #1 Matson Farm

Morrison Drlg. et al Company

Morrison Drlg. - Contr. Contractor

Fairview Pool


Ft. from N. Line

990' Ft. from S. Line

330' Ft. from E. Line

Ft. from W. Line

NE SE NE

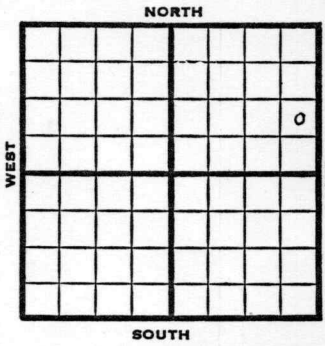

1951	Elev. 1434' REPORT
8/8	Spud 8-5-51 8" @ 90 Drlg. 351'
8/22	Spud 8-5-51 D&A TD 3013 8" @ 90 Burgess 3000-02½ 5" @ 3002 TD 3013 HFW D&A ABANDONED

FORM 275 FOR SALE BY KANSAS BLUE PRINT CO.

County Sedgwick State Kansas

Sec. 7 (Blk. Twp.) 26 (Sur. Rge.) 2E Map No.

Operator Morrison Drlg. etal.

Well No. 1 Farm Matson

Elev. 1434 Location NE SE NE



990 Ft. From S Line NE

330 Ft. From E Line Quarter

AUG 8 1951

1st. Report

Completion

Remarks

Morrison Drlg. - Contr.

Spudding Date 8-5-51

Drlg. Data Fairview Pool

8" @ 90 drlg. 351

J. E. TYRA

FORM 275 FOR SALE BY KANSAS BLUE PRINT CO.

County Sedgwick State Kansas

Sec. 7 (Blk. Twp.) 26 (Sur. Rge.) 2E Map No.

Operator Morrison Drlg. etal.

Well No. 1 Farm Matson

Elev. 1434 Location NE SE NE



990 Ft. From S Line NE

330 Ft. From E Line Quarter

1st. Report

Completion AUG 22 1951

Remarks Fairview Pool

Morrison Drlg. - Contr.

Spudding Date 8-5-51

Drlg. Data D & A TD 3013

8" @ 90 Burgess 3000-02½ 5" @ 3002

TD 3013 HFW D & A

J. E. TYRA