

Section 8 Township 26 Range 2-EWell No. #1 MeyersCompany J. P. Gatty

NORTH

							0

WEST

EAST

SOUTH

KANSAS

Sedgwick

Sec. 8 Twp. 26 R. 2E

Well No. #1 Meyers Farm

J. P. Gatty Company

Miscellaneous


 Ft. from N. Line

990' Ft. from S. Line

330' Ft. from E. Line

 Ft. from W. Line

NE SE NE

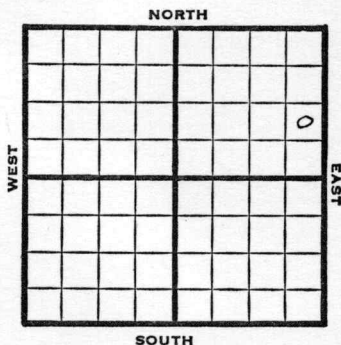

1948 El. 1394' REPORT

5/12 Machine

5/19 15" @ 201'
Drlg. 670'

5/26 Drlg. 1525'

6/1 7" @ 1625'
Drlg. 2250'

6/9 Burgess 2932'
7" @ 2935'
Chat 2955'
TD 3048'

6/16 TD 3048'
Chat. 2955'
Adnadoned...

ABANDONED

Map No. _____ Sec. 8 Twp. 26 R. 2E

Well No. 1 Meyers


J. P. Gatty Company

FIRST REPORT

Contractor

NE SE NE

SECTION PLAT

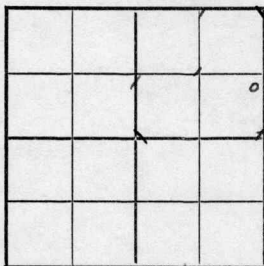

_____ Ft. from N. Line

990 Ft. from S. Line

330 Ft. from E. Line

_____ Ft. from W. Line

Sedgwick County

Location _____

Rig up _____

Drilling and Remarks:

Machine

RECORD

Cased _____ in., _____ ft.

Sand _____

Gas _____

Oil _____

Total Depth _____

PRODUCTION

1st 24 hrs. Nat. _____

1st 24 hrs. after shot _____

Gas _____ Cu. Ft.

Dry Hole _____

Abandoned _____

Date

MAY 1 2 1948 19 _____ S. J. LEWIS Scout

Map No. 13 Sec. 8 Twp. 26 R. 2E

Well No. 1 Meyers

J. P. Gatty Company

ABANDONED

Contractor

NE SE NE

E. 11894
SECTION PLAT .

 Ft. from N. Line

990 Ft. from S. Line

330 Ft. from E. Line

 Ft. from W. Line

			o

Sedgwick County

Location

Rig up

Drilling and Remarks:

Chc 82955

RECORD

Cased in., ft.

Sand

Gas

Oil

Total Depth 3048

PRODUCTION

1st 24 hrs. Nat.

1st 24 hrs. after shot

Gas Cu. Ft.

Dry Hole

Abandoned

Date

JUN 16 1948

19

S. J. LEWIS Scout