

Section 8 Township 26 Range 2E

Well No. 2 Meyers

Company J.P. Gatty

Misc.
NORTH

WEST

EAST

SOUTH

KANSAS

Sedgwick

2E

Sec. 8 Twp. 26 R.

Well No. #2 Meyers Farm

J. P. Gatty Company

Miscellaneous

Ft. from N. Line

330'


Ft. from S. Line

Ft. from E. Line

990'

Ft. from W. Line

SE SW NE

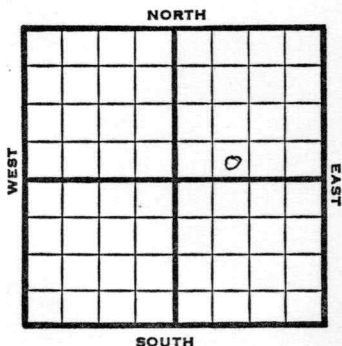

1948

Elev. 1407' REPORT

10/27 Location
11/3 "
11/10 "
11/16 Drlg. 275'
11/23 Drlg 690'
11/30 Drlg 1286'
12/6 10" @ 1577'
Drlg. 1635'
12/14 KC 2502'
Drlg. 2570'
12/22 8" @ 2610'
Drlg. 2805'
12/29 "

1949

1/5 Burgess 2975'
TD 2980'

ABANDONED

Map No. _____ Sec. 8 Twp. 26 R. 2E

Well No. 2 Meyers

J. P. Gatty Company

FIRST REPORT

Contractor

SE SW NE

SECTION PLAT

_____ Ft. from N. Line

330

_____ Ft. from S. Line

_____ Ft. from E. Line

990

_____ Ft. from W. Line

Sedgwick County

Location X

Rig up _____

Drilling and Remarks:

RECORD

Cased _____ in., _____ ft.

Sand _____

Gas _____

Oil _____

Total Depth _____

PRODUCTION

1st 24 hrs. Nat. _____

1st 24 hrs. after shot _____

Gas _____ Cu. Ft.

Dry Hole _____

Abandoned _____

Date

OCT 27 1948

19

S. J. LEWIS

Scout

Kansas

Map No. 13 Sec. 8 Twp. 26 R. 2EWell No. 2 MeyersJ. P. Gatty Company


ABANDONED

Contractor

SE SW NE

E1140?

SECTION PLAT

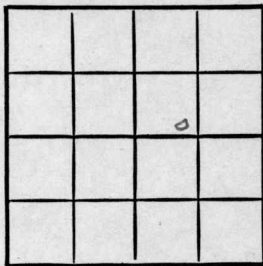 Ft. from N. Line330 Ft. from S. Line Ft. from E. Line990 Ft. from W. Line

Sedgwick County

Location Rig up

Drilling and Remarks:

Burgess 2975

RECORD

Cased in., ft.Sand Gas Oil Total Depth 2970

PRODUCTION

1st 24 hrs. Nat. 1st 24 hrs. after shot Gas Cu. Ft.Dry Hole Abandoned

Date

JAN 5 1949 19

S. J. LEWIS Scout