
KANSAS

FORM 51 25M 3-49 PETROL

Section 8 Township 26 Range 2E

Well No. #3 Phillips

Company J. P. Gatty

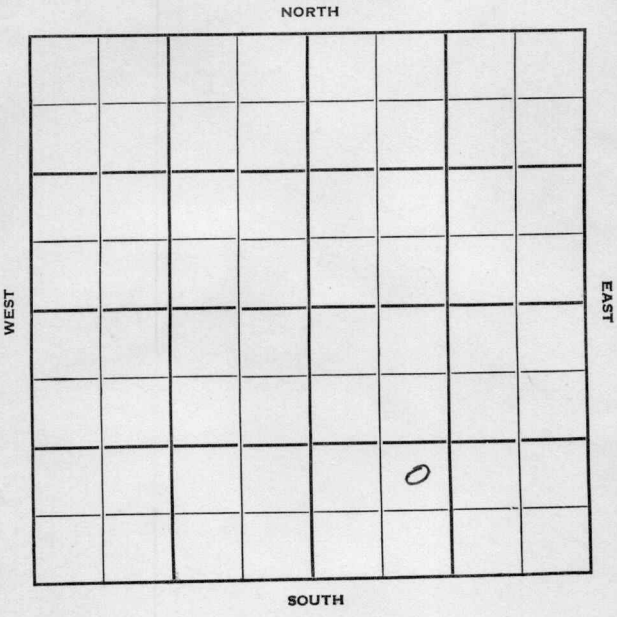

FORM 252-A
5M 10-48 PETROL

Sedgwick KANSAS

Sec. 8 Twp. 26 R. 2E

Well No. #3 Phillips Farm

J. P. Gatty Company

Miscellaneous (Merhenke Drlg., Contr.)


_____ Ft. from N. Line

990' Ft. from S. Line

_____ Ft. from E. Line

990' Ft. from W. Line

NE SW SE

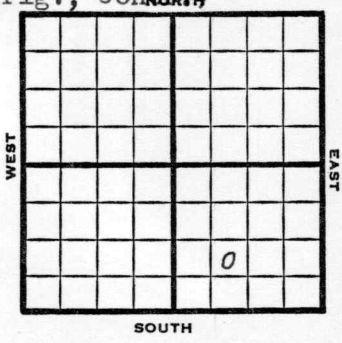

1949	Elev 1407' REPORT
12/14	Surface Hole
12/21	"
12/28	8"@ 110'
o1950	
1/11	TD 2960' 8"@ 110' 7"@ 2958' Sand 2959' D&A Aband.

ABANDONED

Form 26 200 Bks. 6-49 Petrol

Kansas

Miscellaneous

Map No. _____ Sec. 8 Twp. 26 R. 2E

Well No. 3 Phillips


J. P. Gatty Company

Merhenke Drlg. Contractor

NE SW SE

FIRST REPORT

SECTION PLAT

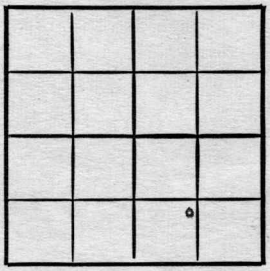

_____ Ft. from N. Line

990 Ft. from S. Line

_____ Ft. from E. Line

990 Ft. from W. Line

Sedgwick County

Location _____

Rig up _____

Drilling and Remarks:

surface hole

RECORD

Cased _____ in., _____ ft.

Sand _____

Gas _____

Oil _____

Total Depth _____

PRODUCTION

1st 24 hrs. Nat. _____

1st 24 hrs. after shot _____

Gas _____ Cu. Ft.

Dry Hole _____

Abandoned _____

Date

DEC 14 1949

19 S. J. LEWIS Scout

Form 26 200 Bks. 6-49 Petrol

Kansas

Miscellaneous

Map No. _____ Sec. 8 Twp. 26 R. 2E

Well No. 3 Phillips


J. P. Gatty Company

Contractor

NE SW SE

Elv. 1407

SECTION PLAT

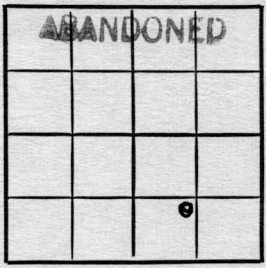

990 Ft. from N. Line

990 Ft. from S. Line

Ft. from E. Line

Ft. from W. Line

Sedgwick County

Location

Rig up

Drilling and Remarks:

8" @ 110
7" @ 2958
Sand 2959
D & A

RECORD

Cased in., ft.

Sand

Gas

Oil

Total Depth 2960

PRODUCTION

1st 24 hrs. Nat.

1st 24 hrs. after shot

Gas Cu. Ft.

Dry Hole

Abandoned

Date

JAN 11 1950

19 J. E. TYRA Scout