


Sedgwick

KANSAS

Section 8 Township 26S Range 2E

Well No. #2 Schramm

Company Eckland

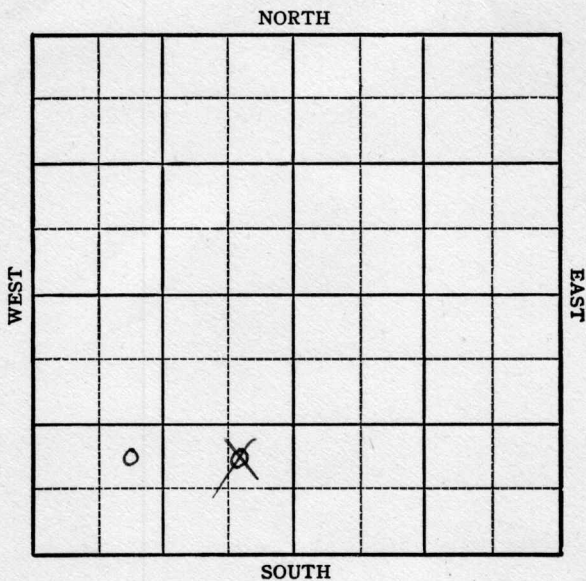

Sedgwick

KANSAS ✓

Sec. 8 Twp. 26 R. 2E

Well No. #2 Schram Farm

Eckland

Company

Miscellaneous (Eckland, Cont.)

NORTH

 Ft. from N. Line


990'

 Ft. from S. Line

 Ft. from E. Line

990'

 Ft. from W. Line

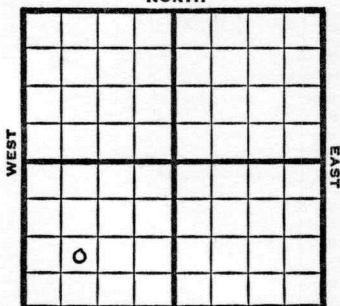

NE SW SW

SOUTH

1949

Lev 1434'

REPORT

9/14

8" @ 98'

9/21

"

9/28

Drlg 2020'

10/5

Burgess 2989'

TD 2989'

7" @ 2984'

10/12

TD 3015'

Miss 3005'

Aband.

ABANDONED

Map No. _____ Sec. 8 Twp. 26 R. 2E


Well No. 2 Schram

Eckland Company

Eckland Contractor

NE SW SW

SECTION PLAT

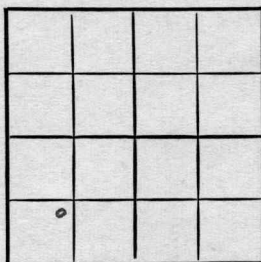

_____ Ft. from N. Line

990 Ft. from S. Line

_____ Ft. from E. Line

990 Ft. from W. Line

Sedgwick County

Location _____

Rig up _____

Drilling and Remarks:

8" @ 98

RECORD

Cased _____ in., _____ ft.

Sand _____

Gas _____

Oil _____

Total Depth _____

PRODUCTION

1st 24 hrs. Nat. _____

1st 24 hrs. after shot _____

Gas _____ Cu. Ft.

Dry Hole _____

Abandoned _____

Date

SEP 14 1949 19

S. J. LEWIS

Scout

Map No. _____ Sec. 8 Twp. 26 R. 2E

Well No. 2 Schram

Eckland Company

ABANDONED Contractor

NE SW SW


E 1/4 1434
SECTION PLAT

_____ Ft. from N. Line

990 Ft. from S. Line

_____ Ft. from E. Line

990 Ft. from W. Line

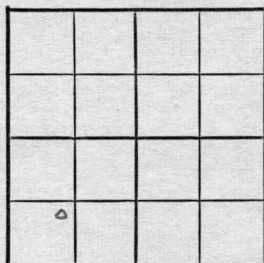

Sedgwick County

Location _____

Rig up _____

Drilling and Remarks:

Miss 3005.

RECORD

Cased _____ in., _____ ft.

Sand _____

Gas _____

Oil _____

Total Depth 3015

PRODUCTION

1st 24 hrs. Nat. _____

1st 24 hrs. after shot _____

Gas _____ Cu. Ft.

Dry Hole _____

Abandoned _____

Date

OCT 12 1949

19

S. J. LEWIS

Scout