
FORM 51 25M 3-49 PETROL

KANSAS

Section 8 Township 26 Range 2E

Well No. #3 Schramm

Company Eckland Drlg.

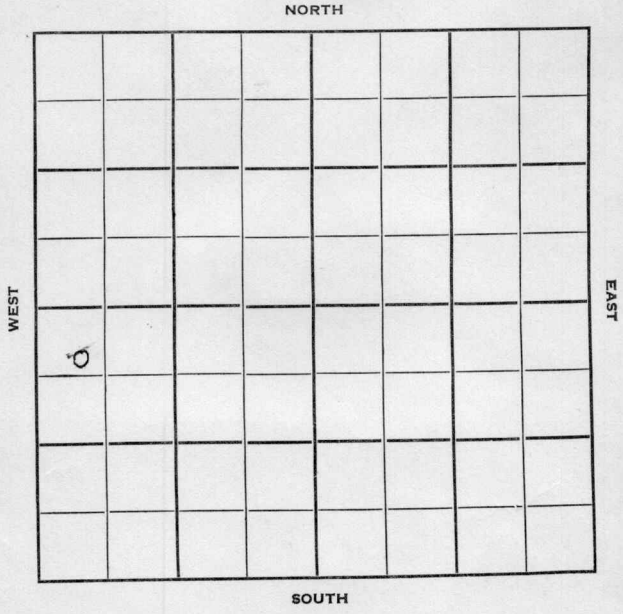

FORM 252-A
5M 10-48 PETROL

Sedgwick KANSAS ✓

Sec. 8 Twp. 26 R. 2E

Well No. #3 Schramm Farm

Eckland Drlg. Company

Fairview Pool


555' Ft. from N. Line

Ft. from S. Line

Ft. from E. Line

425' Ft. from W. Line

C W L NW SW

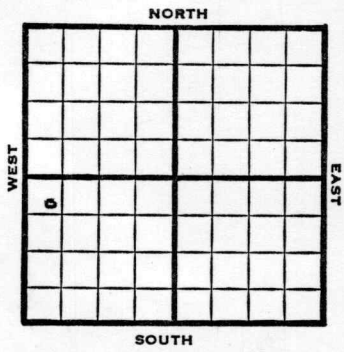

1950	Elev. 1424' REPORT
1/11	Spud 1-8-50 8-5/8" @ 95' Drlg. 1450'
2/22	8-5/8" @ 95 5" @ 2965' No shows D&A TD 3185' ABANDONED

Form 26 200 Bks. 6-49 Petrol

Kansas

Fairview Pool

Map No. _____ Sec. 8 Twp. 26 R. 2E

Well No. 3 Schramm

Eckland Drlg. Company

_____ Contractor

C W L NW SW

555 Ft. from N. Line

_____ Ft. from S. Line

_____ Ft. from E. Line

425 Ft. from W. Line

SECTION PLAT



Sedgwick County

Location _____

Rig up _____

Drilling and Remarks:

Spud 1-8-50

8 5/8" @ 95

drlg. 1450

RECORD

Cased _____ in., _____ ft.

Sand _____

Gas _____

Oil _____

Total Depth _____

PRODUCTION

1st 24 hrs. Nat. _____

1st 24 hrs. after shot _____

Gas _____ Cu. Ft.

Dry Hole _____

Abandoned _____

Date

JAN 11 1950 19

J. E. TYRA Scout

Form 26 200 Bks. 11-49 Petrol Kansas

Fairview Pool

Map No. _____ Sec. 8 Twp. 26 R. 2E

Well No. 3 Schramm

Eckland Drlg. Company

Contractor

C W L NW SW

El. 1424


SECTION PLAT

555 Ft. from N. Line

_____ Ft. from S. Line

_____ Ft. from E. Line

425 Ft. from W. Line

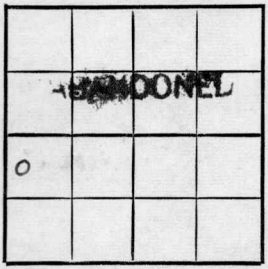

Sedgwick County

Location _____

Rig up _____

Drilling and Remarks:

8 5/8 at 95

5" @ 2965

no Shows

D & A.

RECORD

Cased _____ in., _____ ft.

Sand _____

Gas _____

Oil _____

Total Depth 3185

PRODUCTION

1st 24 hrs. Nat. _____

1st 24 hrs. after shot _____

Gas _____ Cu. Ft.

Dry Hole _____

Abandoned _____

Date

FEB 22 1950 19

J. E. TYRA Scout