

Sec. 9 Twp. 26 R. 2E

Well No. #1 Beach Farm

J. P. Gatty Company


Wildcat (Howell Drlg., Cont.)TH

990' Ft. from N. Line

_____ Ft. from S. Line

990' Ft. from E. Line

_____ Ft. from W. Line

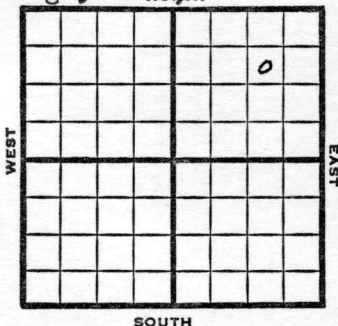

SW NE NE

SOUTH

1949

Elev 1378'

REPORT

7/6 Location

7/12 Spud

7/20 15" @ 90'

Drlg 680'

7/27 13" @ 1094'

Drlg 1475'

8/3 10" @ 1535'

Drlg. 1912'

8/10 TD 2550'

8/16 8" @ 2562'

Drlg. 3052'

8/24 TD 3286'

8/31 TD 3325'

9/7 TD 3372'

9/14 TD 3372'

Miss 2912

Arb. 3313'

Aband.

ABANDONED

Map No. _____ Sec. 9 Twp. 26 R. 2E

Well No. 1 Beech

J. P. Gatty Company

Howell Drlg. Contractor

SW NE NE


FIRST REPORT
SECTION PLAT

990 Ft. from N. Line

_____ Ft. from S. Line

990 Ft. from E. Line

_____ Ft. from W. Line

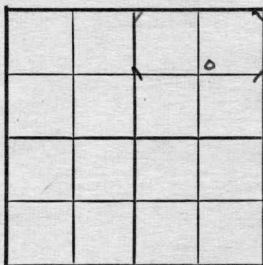

Sedgwick County

Location X

Rig up _____

Drilling and Remarks:

RECORD

Cased _____ in., _____ ft.

Sand _____

Gas _____

Oil _____

Total Depth _____

PRODUCTION

1st 24 hrs. Nat. _____

1st 24 hrs. after shot _____

Gas _____ Cu. Ft.

Dry Hole _____

Abandoned _____

Date

JUL 6 1949 19 _____

S. J. LEWIS Scout

Map No. K13 Sec. 9 Twp. 26 R. 2E

Well No. 1 Beech

J. P. Gatty Company

ABANDONED

Contractor

SW NE NE

E. 1, 1978
SECTION PLAT

990 Ft. from N. Line

_____ Ft. from S. Line

990 Ft. from E. Line

_____ Ft. from W. Line

			0

Sedgwick County

Location _____

Rig up _____

Drilling and Remarks:

Misc 2912
Cart 3313

RECORD

Cased _____ in., _____ ft.

Sand _____

Gas _____

Oil _____

Total Depth 3872

PRODUCTION

1st 24 hrs. Nat. _____

1st 24 hrs. after shot _____

Gas _____ Cu. Ft.

Dry Hole _____

Abandoned _____

Date

SEP 14 1949 19

S. J. LEWIS Scout