


Cowley
8E

Map No. KANSAS Sec. 21 Twp. 30 R. 8E

Well No. 1 Ferguson Farm
W. H. Lassen Company

_____ Ft. from N. Line
330 Ft. from S. Line
330 Ft. from E. Line
_____ Ft. from W. Line

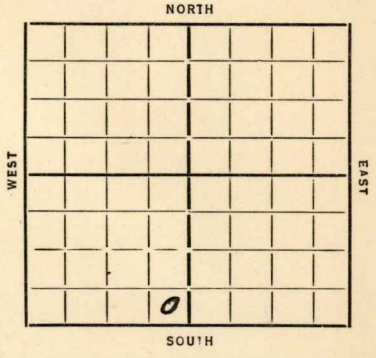

Date 7/29/34

REPORT

10/17 Location

10/25 _____

11/1 Dly 500

11/8 " 940

11/15 " 1105

11/22 " 1415

11/28 " 1700

12/6 " 2045 6" 2035

12/13 K.C. 2027 1 1/2 m Has 2056-58
Dly 2152

12/21 Pay 2169-72 5" 2160
HFO Bldg tanks

12/27 _____ 1/3/35 _____

1/19 1000 acid

1/17 Re run pipe

1/24 _____

1/31 T 7 2181 1000 acid

2/7 60 Bbls, Reacidize

2/14 _____ 2/21-2/28 _____

3/6 K.C. line 2027 T 7 2181
1000 acid 1000 acid
90 Bbls.

COMPLETED

Cowley
Form 26—1M Bks.—2-29

KANSAS

Map No. 10 Sec. 21 Twp. 30 R. 8E

Well No. 1-Of Ferguson

W. H. Larsen Company

Contractor

FIRST REPORT

SECTION PLAT

_____ Ft. from N. Line

330 Ft. from S. Line

330 Ft. from E. Line

_____ Ft. from W. Line

Location ✓

Rig up _____

Drilling and Remarks:

RECORD

Cased _____ in., _____ ft.

Sand _____

Gas _____

Oil _____

Total Depth _____

PRODUCTION

1st 24 hrs. Nat. _____

1st 24 hrs. after shot _____

Gas _____ Cu. Ft.

Dry Hole _____

Abandoned _____

Date

10-17-34 19

ORVAL MANNSCHECK Scout

Map No. 10 Sec. 21 Twp. 30 R. 8E

Well No. 1 - Ferguson

W. H. Lassen Company

Contractor

SECTION PLAT

..... Ft. from N. Line

330 Ft. from S. Line

330 Ft. from E. Line

..... Ft. from W. Line

COMPLETED

Location.....

Rig up.....

Drilling and Remarks:

1000 acid
1000 acid

90 bbls

RECORD

Cased..... in., ft.

Sand K.C. June 2027

Gas.....

Oil.....

Total Depth 2181

PRODUCTION

1st 24 hrs. Nat.....

1st 24 hrs. after shot.....

Gas..... Cu. Ft.

Dry Hole.....

Abandoned.....

Date

3-6-35 192.....

ORVAL MANNSCHRECK

Scout