


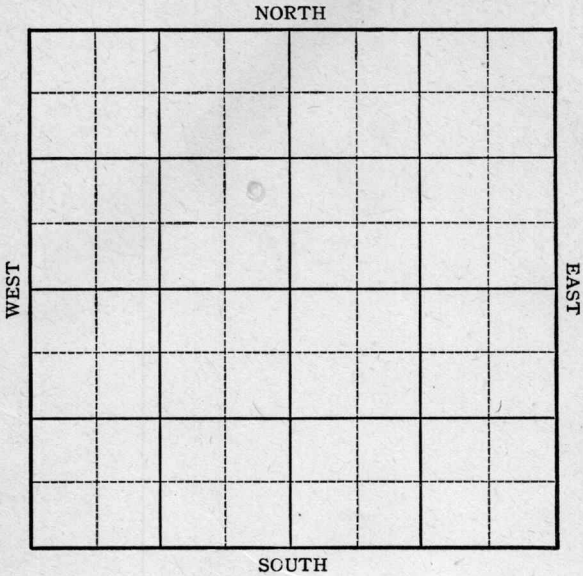

Section 27 Township 25 Range 15E

Well No. #1 Etna Life Ins.

Company Bird-Handley & Sheedy



Sec. 27 Twp. 25 R. 15E

Well No. #1 Etna Life Ins. Farm

Bird-Handley & Sheedy Company


Miscellaneous

_____ Ft. from N. Line

990 Ft. from S. Line

330 Ft. from E. Line

_____ Ft. from W. Line

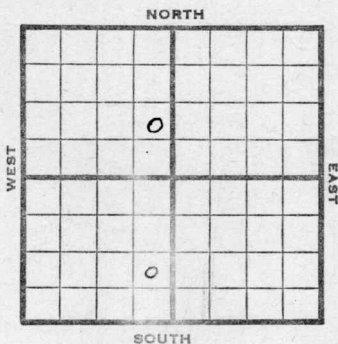

NE SE NW

1945 R E P O R T

3/14 Spud
 3/23 10" @ 90'
 Drlg. 770'
 3/29 8" @ 800
 Miss 1513
 Run 7"
 4/5 7" @ 1513' WOC
 4/12 TD 1532'
 4-18 Miss 1513'
 7" at 1513'
 500 acid
 Pump 40 pot
 38 Gravity
 Total Depth 1532'

COMPLETED

Pool Name Miscellaneous

Map No. 17 Sec. 27 Twp. 25 R. 15^E

Well No. 1 Etna Life Ins.

Bird-Handley & Sheedy Company

FIRST REPORT

Contractor

NE SE NW

SECTION PLAT

_____ Ft. from N. Line

990 Ft. from S. Line

330 Ft. from E. Line

_____ Ft. from W. Line

	o		

Woodson

Location _____

Rig up _____

Drilling and Remarks:

spud

RECORD

Cased _____ in., _____ ft.

Sand _____

Gas _____

Oil _____

Total Depth _____

PRODUCTION

1st 24 hrs. Nat. _____

1st 24 hrs. after shot _____

Gas _____ Cu. Ft.

Dry Hole _____

Abandoned _____

Date

MAR 14 1945

19

S. J. LEWIS Scout

