

Sedgwick


DX 78-1

KANSAS

Section 9 Township 26 Range 2E

Well No. #1 Winter

Company Chas. Carlock

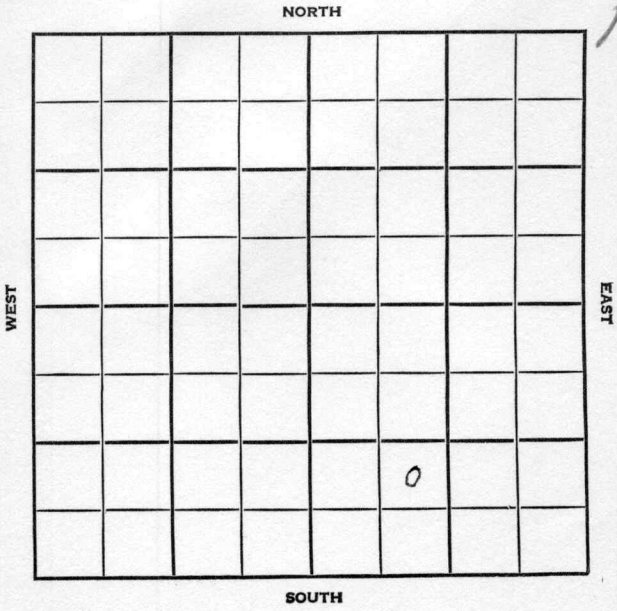

Sedgwick

KANSAS


| | | |
|------------------|-------------------|-----------------|
| SEC. 9 | TWP. 26 | R. 2E |
|------------------|-------------------|-----------------|

WELL NO. **#1 Winter**
 COMPANY **FARM**

Chas. Carlock

CONTRACTOR **Bedell & Catt**

Fairview Pool^{DRTH}

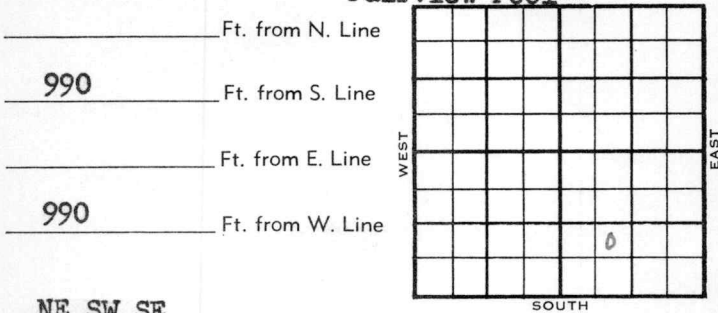

| | | |
|-------------|---------------------------|--------|
| 1954 | ELEVATION 1374' | REPORT |
|-------------|---------------------------|--------|

| | |
|-------------|--|
| 12/1 | Spud 11-29-54 8" @ 105' WOC. |
| 12/8 | Spud 11-29-54 - D&A TD 2910' 8" @ 105' Lans 2243', KC 2433', B KC 2612', Miss 2906' DST 2899-2910', opn 1 hr., rec. 380' SW TD 2910' D&A |

ABANDONED

