


Map No. KANSAS Sec. 10 Twp. 26 R. 2E

Well No. 1-Miers Farm
Wentz Oil Corp. Company

NORTH

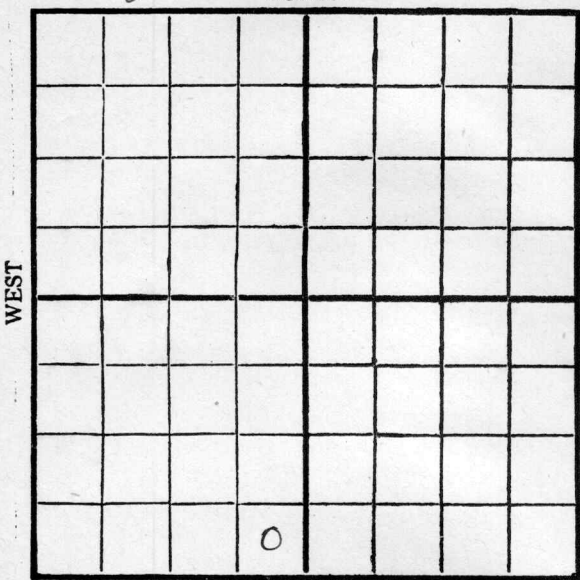

SOUTH

Location _____

Drilling Remarks _____

Rig Up _____

Drilling Remarks _____

RECORD

Cased _____ in. _____ ft.

Sand _____

Gas _____

Oil _____

Total Depth _____

PRODUCTION

1st 24 hrs. Nat. _____

1st 24 hrs. after shot _____

Gas _____ cu. ft. _____

Dry Hole _____


Abandoned _____

Dulywick

Map No. KANSAS Sec. 10 Twp. 26 R. 2^E

Well No. 1-1-1 Muris Farm
Kentz Oil Corp Company

_____ Ft. from N. Line
330 Ft. from S. Line
330 Ft. from E. Line
 _____ Ft. from W. Line

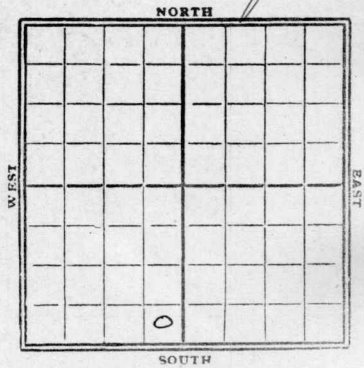

1929

Date REPORT

Date	REPORT
<u>7/31</u>	<u>Log</u>
<u>8/7</u>	<u>Log</u>
<u>8/14</u>	<u>Rig up</u>
<u>8/21</u>	<u>Spudding</u>
<u>8/28</u>	<u>llg 640'</u>
<u>9/4</u>	<u>" 1340</u>
<u>9/11</u>	<u>" 2000</u>
<u>9/18</u>	<u>" 2590'</u>
<u>9/25</u>	<u>top chat 2900</u>
	<u>HFW 2905-12</u>
	<u>llg 2912</u>
<u>10/2</u>	<u>" 3070'</u>
<u>10/9</u>	<u>HFW at 3184'</u>
	<u>T.D. 3187</u>
	<u>Dry & Abandoned</u>

Sedgwick

K13 **KANSAS** Map No. _____ Sec. *10* Twp. *26* R. *2* ^E

Well No. *1* *Miers*

Wentz Oil Corp. Company

Contractor

FIRST REPORTS

SECTION PLAT

_____ Ft. from N. Line

330 Ft. from S. Line

330 Ft. from E. Line

_____ Ft. from W. Line

Location _____

Rig up *B.O.S.*

Drilling and Remarks:

RECORD

Cased _____ in., _____ ft.

Sand _____

Gas _____

Oil _____

Total Depth _____

PRODUCTION

1st 24 hrs. Nat. _____

1st 24 hrs. after shot _____

Gas _____ Cu. Ft.

Dry Hole _____

Abandoned _____

Date **JUL 3 1 1929**

CHAS. L. SHERWOOD

Edgwick
 Map No. KANSAS Sec. 10 Twp. 26 R. 2E
 Well No. 1 Miss
Hertz Oil Corp Company
 Contractor

SECTION PLAT

..... Ft. from N. Line
330 Ft. from S. Line
330 Ft. from E. Line
 Ft. from W. Line

ABANDONED

Location.....
 Rig up.....
 Drilling and Remarks:

AFW 8154

RECORD

Cased.....in.,ft.
 Sand.....
 Gas.....
 Oil.....
 Total Depth 3187

PRODUCTION

1st 24 hrs. Nat.....
 1st 24 hrs. after shot.....
 Gas.....Cu. Ft.
 Dry Hole.....
 Abandoned.....

Date

OCT 9 1929 192..... S. J. LEWIS Scout