


Map No. Kansas Sec. 28 Twp. 30 R. 8^E

Well No. 1 Ferguson Farm

Heatt & Ferguson Company

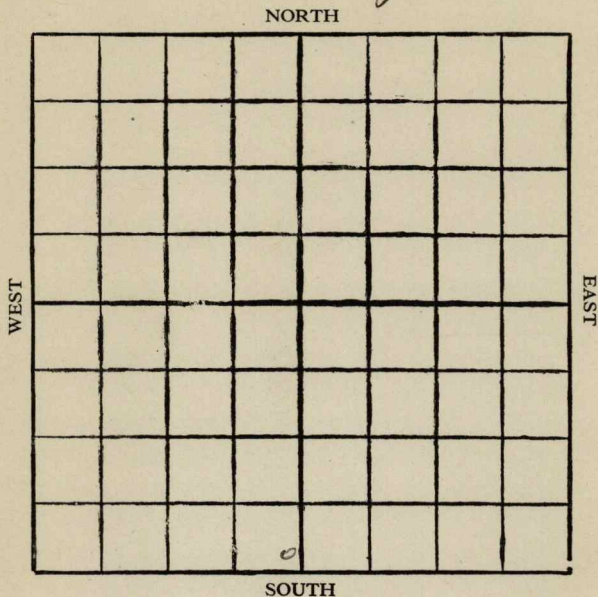

Location

Drilling Remarks

.....

.....

RECORD

Cased.....in.ft.

Sand

Gas

Oil

Total Depth.....

Rig Up.....

Drilling Remarks

.....

.....

PRODUCTION

1st 24 hrs. Nat.....

1st 24 hrs. after shot.....

Gas.....cu. ft.

Dry Hole.....

Abandoned.....


Map No. _____ Sec. 28 Twp. 30 R. 8 EWell No. 1 - Ferguson Farm
Hiatt & Ferguson Company

NORTH

_____ Ft. from N. Line

330 Ft. from S. Line330 Ft. from E. Line

_____ Ft. from W. Line

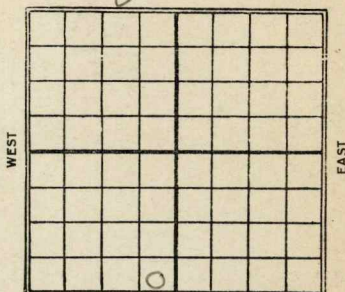

SOUTH

1927

Date

REPORT

5/5	Ro G
5/17	Ring
5/18	
5/25	Spudding
6/1	Spud 250
6/7	Drly 650
6/15	" 1130
6/22	" 1490
6/29	" 2000
7/7	" 2340
7/13	" 2680
7/20	" 2900
7/28	" 3085
8/4	fishing 3238'
8/10	Setting 5" - 3245-
8/18	Sand 3261-71
	Drly 3390'
8/24	Ad. 3261-71-dry - S.D. 3420
9/1	
9/7	
9/14	Dry Sand 3261-71
	Dry d. 3425

10 **KANSAS** 28 30 8 E
 Map No. _____ Sec. _____ Twp. _____ R. _____

Well No. 1 *Ferguson* _____

Hiatt & Ferguson _____ Company

_____ Contractor

FIRST REPORTS

_____ Ft. from N. Line

330 _____ Ft. from S. Line

330 _____ Ft. from E. Line

_____ Ft. from W. Line

SECTION PLAT

Location _____

Rig up _____

Drilling and Remarks:

R.O.S.

RECORD

Cased _____ in., _____ ft.

Sand _____

Gas _____

Oil _____

Total Depth _____

PRODUCTION

1st 24 hrs. Nat. _____

1st 24 hrs. after shot _____

Gas _____ Cu. Ft.

Dry Hole _____

Abandoned _____

Date

MAY 5 1927

192

CHAS. L. SHERWOOD

Scout

10 **KANSAS** Sec. 28 Twp. 30 R. 8

Well No. 1 Ferguson
 Hattie E. Ferguson Company
 Contractor

COMPLETED**SECTION PLAT**

	0		

Ft. from N. Line

320 Ft. from S. Line

320 Ft. from E. Line

Ft. from W. Line

ABANDONED

Location

Rig up

Drilling and Remarks:

Dry hole 3rd 71'

D H

3425

RECORD

Cased in., ft.

Sand

Gas

Oil

Total Depth 2425

PRODUCTION

1st 24 hrs. Nat.

1st 24 hrs. after shot

Gas Cu. Ft.

Dry Hole ✓

Abandoned ✓

Date

SEP 14 1927

CHAS. L. SHERWOOD

192

Scout