

Section 35 Township 20 Range 12W

Well No. 1 Batchman "C"

Company CRA & North American Prod.

NORTH

					0		

WEST

EAST

SOUTH

Barton

KANSAS

Sec. 35 Twp. 20 R. 12W

Well No. #1 Batchman "C" Farm

CRA & North American Prod. Company

Honaker Drlg. -Contr. Contractor

Batchman Pool


330' Ft. from N. Line

_____ Ft. from S. Line

_____ Ft. from E. Line

990' Ft. from W. Line

NE NW NE

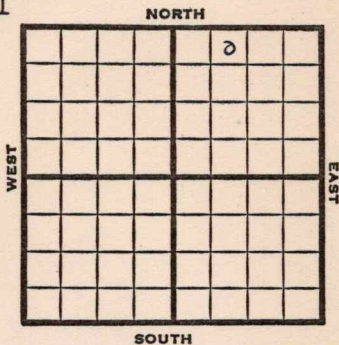

1951

Elev. 1823' REPORT

8/1 Spud 7-30-51
8" @ 271'

10/3 Spud 7-30-51
 Oil well TD 3373' 8" @ 271'
Heeb 2991' **Tor. 3006'** **Br. lime**
3117', **Lans. 3130'** **Arb. 3361-62'**
 5" @ 3361' TD 3366' B/12 GO 1/2 hr.
 DD 3368 FU 400' oil 1 hr.
 S/5 BO 1 hr. S/2 BOPH DD 3373'
 S/21 BO 3 hr. 1000 A
 S/5 1/4 BOPH
 Comp. 42 BOPD

COMPLETED

